

# CERTIFICATE OF LOCATION OF GOVERNMENT CORNER

County of Anoka

State of Minnesota



Witness Corner of Sec. 1 Township 31 Range 24  
(On east line of SE1/4)

On the 3rd day of February, 1976, the described corner was evidenced by area resurvey

and to perpetuate the location of said corner, at the exact location thereof, a permanent marker was placed consisting of a cast iron monument with a steel post on the north side

AND on the 22nd day of March, 2010, said permanent marker was found flush and the ties were updated

Updated reference ties are as shown below.

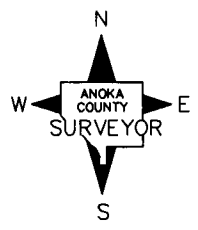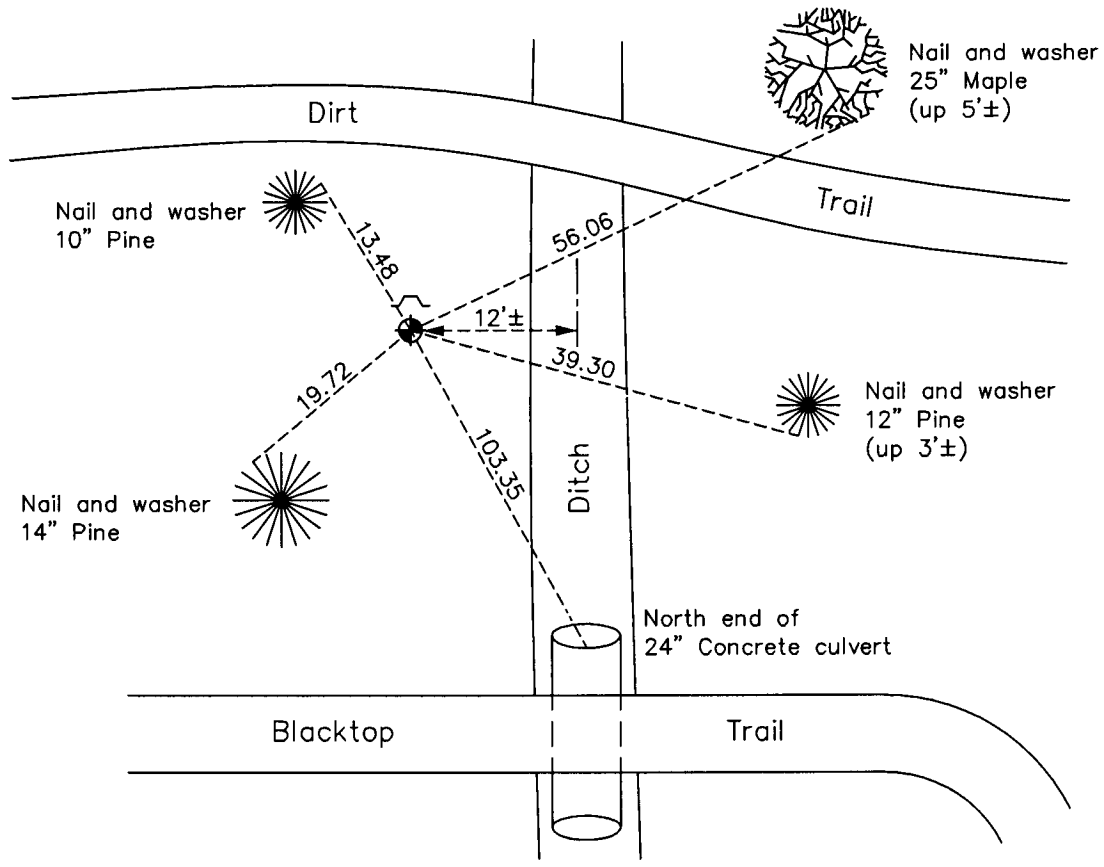

N.A.D. 1983 Coordinates  
(1996 Adjustment)

County Project Coordinates	
Northing	160935.1893
Easting	500206.8996
Date	2/03/00

Revision Date  
**4/23/10**

I hereby certify that this United States public land survey monument record is correct and complete to the best of my knowledge and belief.

*Larry D. Hoium* Date 4/23/10  
 \_\_\_\_\_  
 Larry D. Hoium, Anoka County Surveyor  
 Minnesota License Number 18165

# HISTORY OF GOVERNMENT CORNER

Page No. 26

County of Anoka

State of Minnesota

Witness Corner of Sec. 1 Township 31 Range 24  
(On east line of SE1/4)

## **CORNER HISTORY:**

February 3, 1976 - Set cast iron monument using area resurvey, set a sign and post on the north side and established ties to monument.

June 16, 1977 - Found cast iron monument and updated ties.

June 23, 1980 - Found cast iron monument and updated ties.

July 15, 1983 - Found cast iron monument and updated ties.

June 18, 1986 - Found cast iron monument and updated ties.

February 3, 2000 - Found cast iron monument with a sign and post on the north side and established NAD 1983 (1996 Adjustment) Anoka County Project Coordinates by Static GPS methods. Updated ties.

March 22, 2010 - Found cast iron monument flush with surface and updated ties. Sign and post were missing and need to be replaced.