

CERTIFICATE OF LOCATION OF GOVERNMENT CORNER

County of Anoka

State of Minnesota



South $\frac{1}{4}$ Corner of Sec. 2 Township 31 Range 24

On the 24th day of August, 1960, the described corner was evidenced by a railroad spike

and to perpetuate the location of said corner, at the exact location thereof, a permanent marker was placed consisting of a cast iron monument

AND on the 22nd day of August, 2012, said permanent marker was replaced with an 8" long cast iron monument after road construction was completed

Updated reference ties are as shown below.

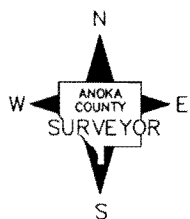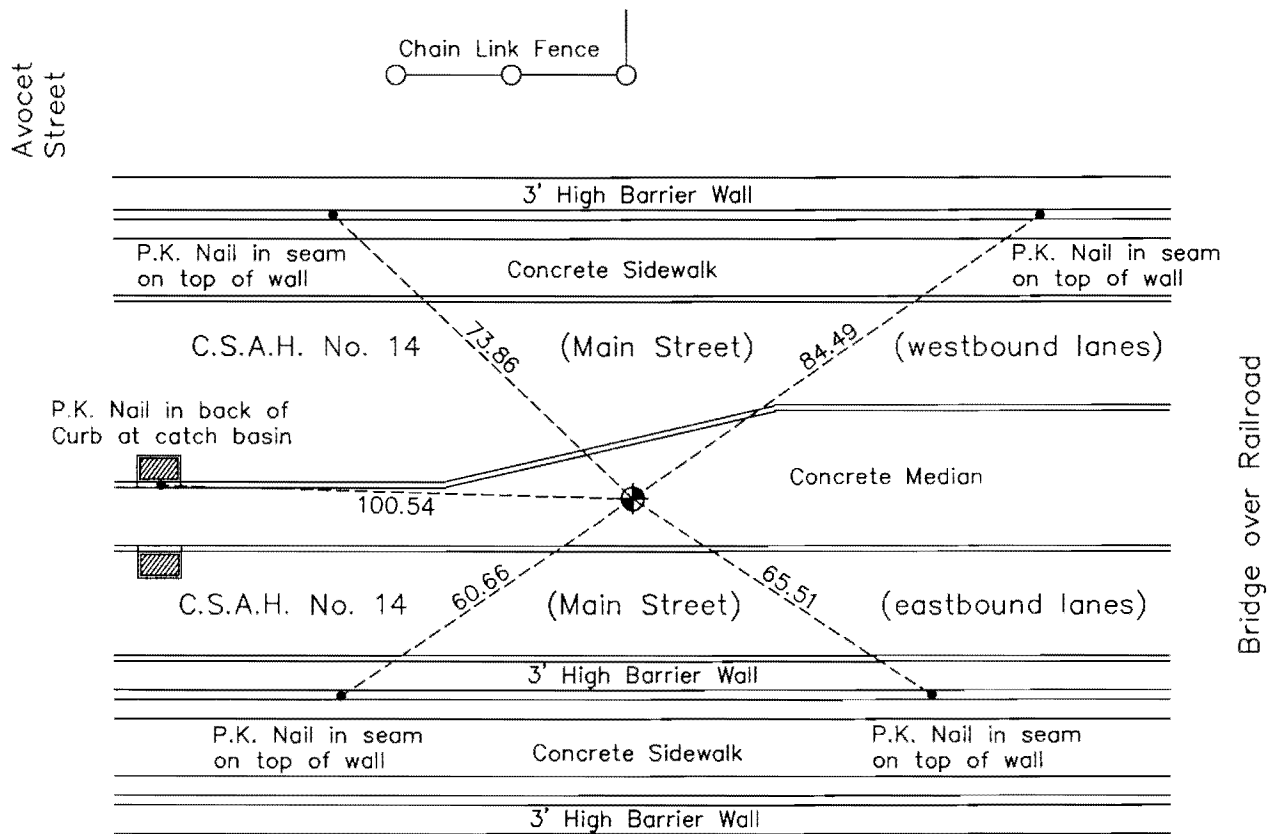

Revision Date
12/21/12

N.A.D. 1983 Coordinates
(1996 Adjustment)

County Project Coordinates	
Northing	<u>159013.2932</u>
Easting	<u>492284.3774</u>
Date	<u>9/27/01</u>

I hereby certify that this United States public land survey monument record is correct and complete to the best of my knowledge and belief.

Larry D. Hoium Date 12/21/12

Larry D. Hoium, Anoka County Surveyor
Minnesota License Number 18165

HISTORY OF GOVERNMENT CORNER

Page No. 30

County of Anoka

State of Minnesota

South 1/4 Corner of Sec. 2 Township 31 Range 24

CORNER HISTORY:

August 24, 1960 - Found railroad spike down 4'. Set cast iron monument flush with surface. Established ties to monument.

June 29, 1964 - Found cast iron monument and updated ties.

July 18, 1966 - Found cast iron monument and updated ties.

July 22, 1970 - Found cast iron monument, set P.K. nails 2.00' North and East, raised monument 3 1/2" and updated ties.

July 4, 1974 - Found cast iron monument and updated ties.

June 20, 1977 - Found cast iron monument and updated ties.

June 24, 1980 - Found cast iron monument, raised monument to flush with surface and updated ties.

December 15, 1983 - Found cast iron monument and updated ties.

June 24, 1986 - Found cast iron monument and updated ties.

August 9, 1994 - Found cast iron monument and updated ties.

September 27, 2001 - Found cast iron monument and established NAD 1983 (1996 Adjustment) Anoka County Project Coordinates by Static GPS methods. Updated ties.

March 31, 2010 - Found cast iron monument down 0.3' and under the south centerline stripe and updated ties.

June 21, 2011 - Updated ties, verified location with VRS and removed cast iron monument prior to road construction.

August 22, 2012 - Set cast iron monument flush with surface after road construction using ties. Verified location of corner by Static GPS methods.