

CERTIFICATE OF LOCATION OF GOVERNMENT CORNER

County of Anoka

State of Minnesota



Southwest Corner of Sec. 2 Township 31 Range 24

On the 22nd day of August, 1960, the described corner was evidenced by a cast iron monument

and to perpetuate the location of said corner, at the exact location thereof, a permanent marker was placed consisting of a cast iron monument

AND on the 22nd day of July, 2011, said permanent marker was raised to the new road surface

Updated reference ties are as shown below.

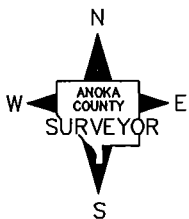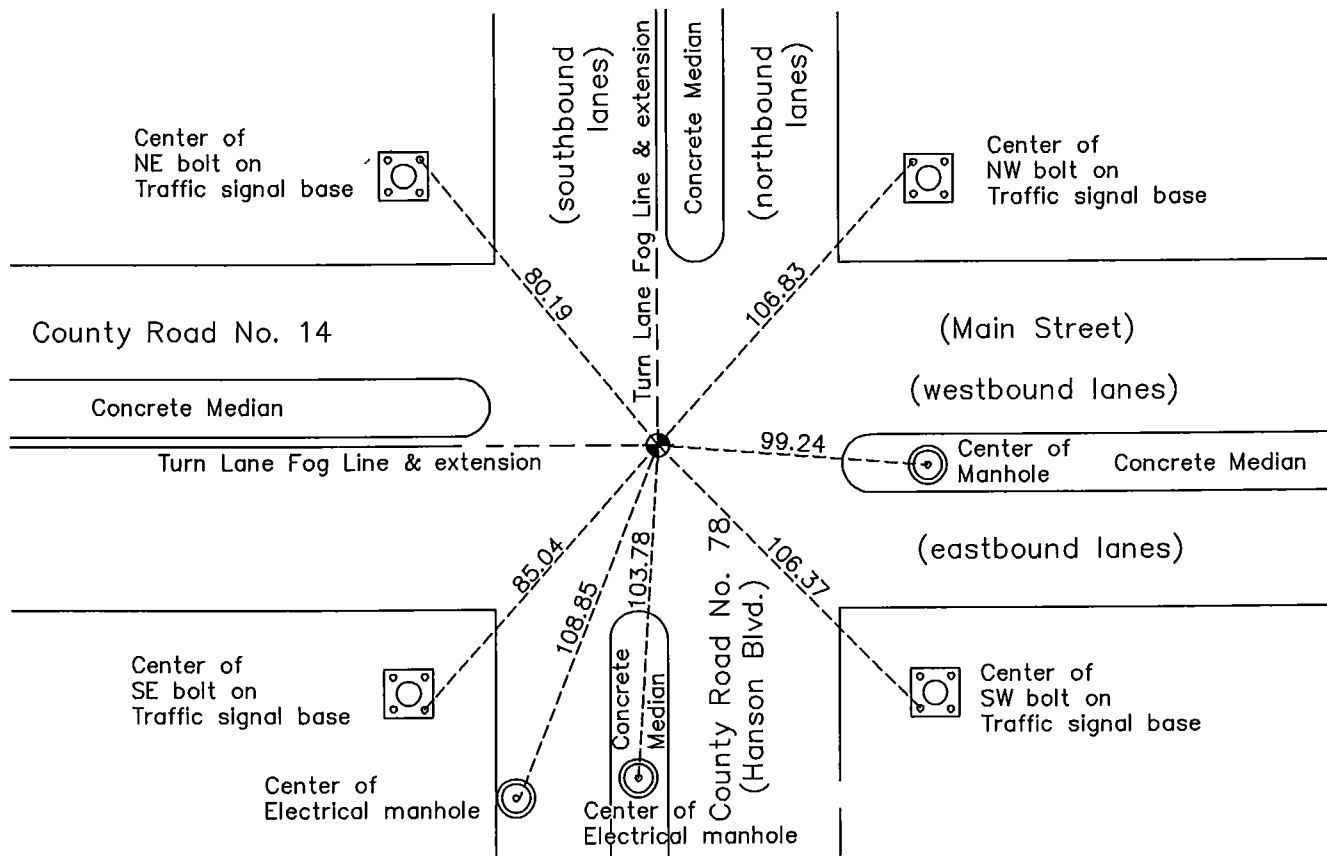

Revision Date
5/22/12

N.A.D. 1983 Coordinates
(1996 Adjustment)

County Project Coordinates	
Northing	159114.8237
Easting	489702.2096
Date	9/27/01

I hereby certify that this United States public land survey monument record is correct and complete to the best of my knowledge and belief.

Larry D. Holum Date 5/22/12

Larry D. Holum, Anoka County Surveyor
Minnesota License Number 18165

HISTORY OF GOVERNMENT CORNER

Page No. 31

County of Anoka

State of Minnesota

Southwest Corner of Sec. 2 Township 31 Range 24

CORNER HISTORY:

August 22, 1960 - Found cast iron monument flush with surface. Established ties to monument.

June 29, 1964 - Found cast iron monument and updated ties.

July 18, 1966 - Found cast iron monument and updated ties.

July 21, 1970 - Found cast iron monument and updated ties.

July 5, 1974 - Found cast iron monument and updated ties.

June 17, 1977 - Found cast iron monument and updated ties.

June 25, 1981 - Set construction ties (1/2" iron pipes on line to the North) and removed cast iron monument prior to road construction.

October 16, 1981 - Set P.K. nail after road construction using construction ties.

June 27, 1986 - Set cast iron monument after road construction using construction ties and area resurvey. Set P.K. nails 2.00' North and East and updated ties.

June 24, 1991 - Found cast iron monument and updated ties.

August 4, 1994 - Found cast iron monument and updated ties.

September 27, 2001 - Found cast iron monument and established NAD 1983 (1996 Adjustment) Anoka County Project Coordinates by Static GPS methods. Updated ties.

March 31, 2010 - Found cast iron monument 0.3' below asphalt surface and updated ties.

July 22, 2011 - Raised cast iron monument to flush with the new road surface.