

CERTIFICATE OF LOCATION OF GOVERNMENT CORNER

County of Anoka

State of Minnesota



North 1/4 Corner of Sec. 9 Township 31 Range 24

On the 26th day of September, 1962, the described corner was evidenced by a concrete monument

and to perpetuate the location of said corner, at the exact location thereof, a permanent marker was placed consisting of a 1/2" iron pipe in concrete section of median

AND on the 18th day of March, 2010, said permanent marker was found and the ties were updated

Updated reference ties are as shown below.

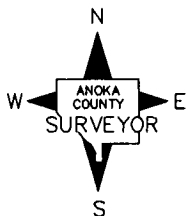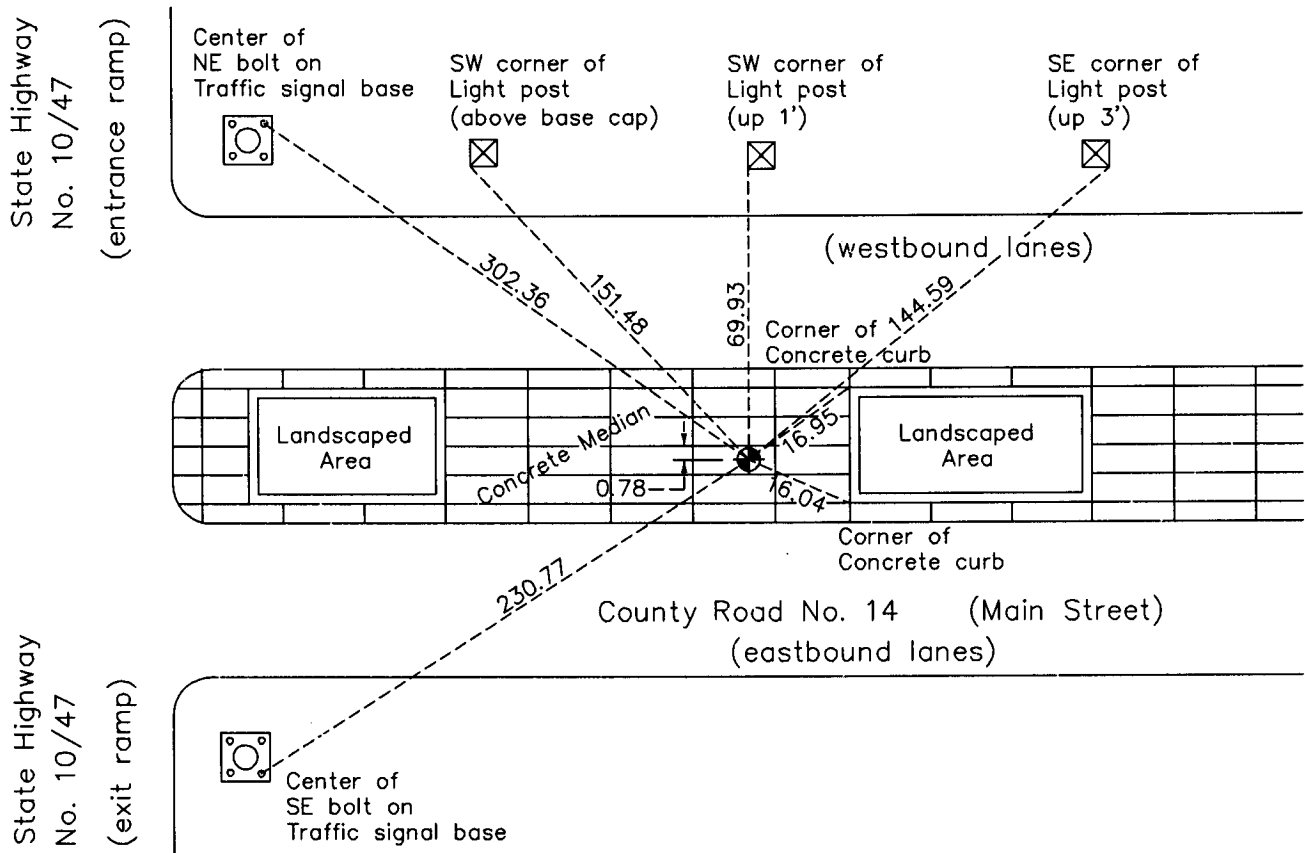

Revision Date
4/26/10

N.A.D. 1983 Coordinates
(1996 Adjustment)

County Project Coordinates	
Northing	<u>159184.0426</u>
Easting	<u>481712.3851</u>
Date	<u>9/14/01</u>

I hereby certify that this United States public land survey monument record is correct and complete to the best of my knowledge and belief.

Larry D. Hoium Date 4/26/10

Larry D. Hoium, Anoka County Surveyor
Minnesota License Number 18165

HISTORY OF GOVERNMENT CORNER

Page No. 34

County of Anoka

State of Minnesota

North 1/4 Corner of Sec. 9 Township 31 Range 24

CORNER HISTORY:

August 18, 1944 - H.A. Cartwright found concrete monument down 3". Established ties to monument.

September 26, 1962 - Found 3/4" iron pipe down 0.5' using Minder Engineering Co. ties. Dug down and found 4" square concrete monument down 2'. Set cast iron monument flush with blacktop surface and updated ties.

March 26, 1964 - Set construction (transit) ties prior to road construction and removed cast iron monument. Cast iron monument is 0.45' South of straight line between NE and NW corners of Section 9.

November 8, 1965 - Set cast iron monument flush with surface after road construction using construction ties.

July 21, 1966 - Found cast iron monument and updated ties.

August 4, 1970 - Found cast iron monument and updated ties.

June 17, 1977 - Found cast iron monument and updated ties.

July 25, 1983 - Found cast iron monument and updated ties.

June 24, 1986 - Found cast iron monument and updated ties.

June 25, 1991 - Found cast iron monument and updated ties.

August 9, 1994 - Found cast iron monument and updated ties.

March 10, 2000 - Set construction ties and removed cast iron monument prior to road construction.

September 14, 2001 - Found type of monument set depth of monument in type of surface and established NAD 1983 (1996 Adjustment) Anoka County Project Coordinates by Static GPS methods. Updated ties.

October 12, 2001 - Set 1/2" iron pipe flush with concrete median surface after road construction using construction ties. Verified location of corner by Static GPS methods and updated ties.

March 18, 2010 - Found 1/2" iron pipe in concrete median and updated ties.