

CERTIFICATE OF LOCATION OF GOVERNMENT CORNER

County of Anoka

State of Minnesota



South 1/4 Corner of Sec. 5 Township 31 Range 24

On the 16th day of August, 1960, the described corner was evidenced by a granite monument

and to perpetuate the location of said corner, at the exact location thereof, a permanent marker was placed consisting of a cast iron monument

AND on the 25th day of March, 2010, said permanent marker was found and the ties were updated

Updated reference ties are as shown below.

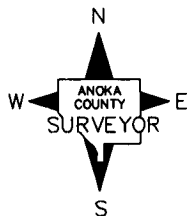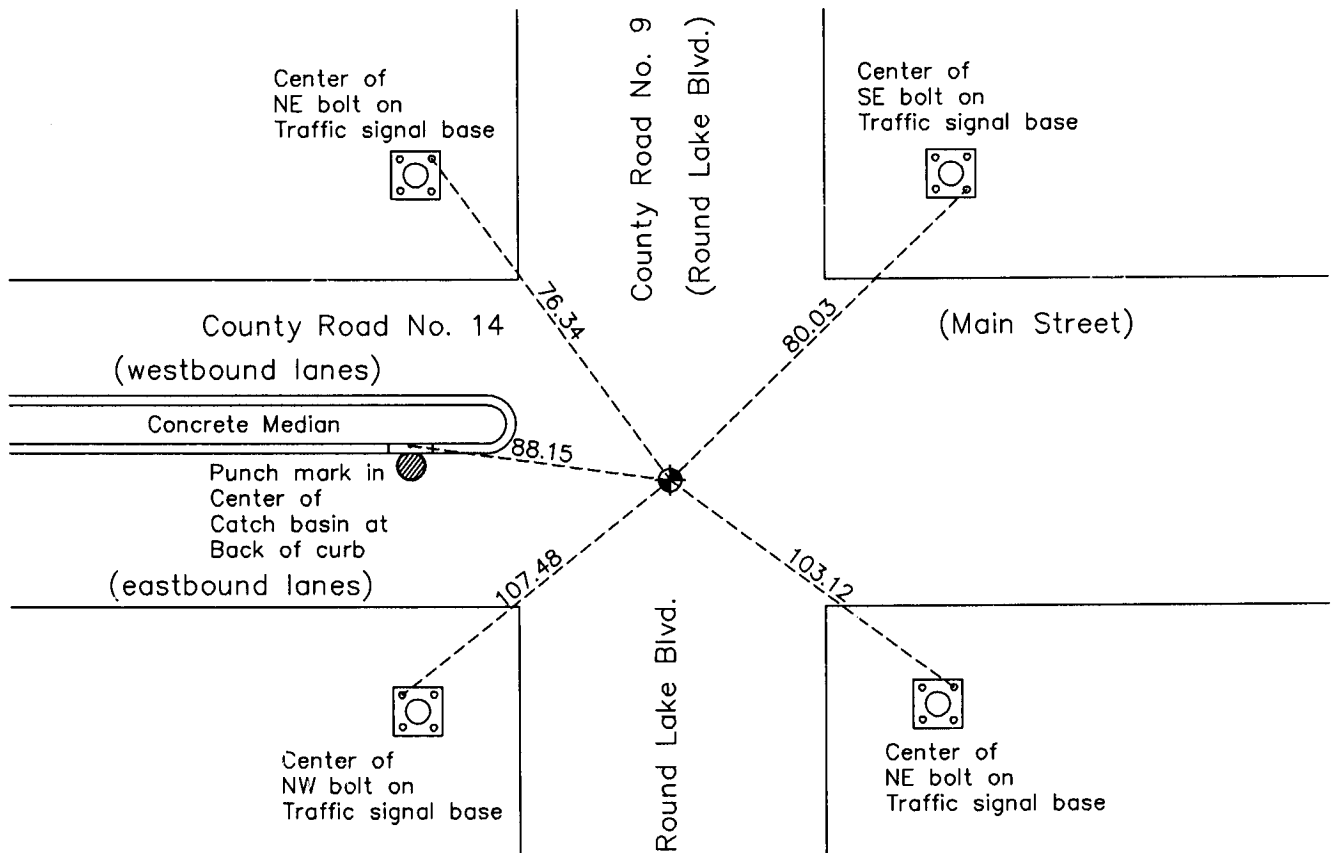

Revision Date
4/28/10

N.A.D. 1983 Coordinates
(1996 Adjustment)

County Project Coordinates	
Northing	<u>159169.8368</u>
Easting	<u>476440.0462</u>
Date	<u>9/28/01</u>

I hereby certify that this United States public land survey monument record is correct and complete to the best of my knowledge and belief.

Larry D. Hoium Date 4/28/10

Larry D. Hoium, Anoka County Surveyor

Minnesota License Number 18165

HISTORY OF GOVERNMENT CORNER

Page No. 36

County of Anoka

State of Minnesota

South 1/4 Corner of Sec. 5 Township 31 Range 24

CORNER HISTORY:

April 23, 1943 - H. A. Cartwright found granite monument down 10" with iron pipe on East side in centerline of Main Street. Established ties to monument.

August 9, 1955 - C.E. Coulter found granite monument down 3.5' in centerline of Main Street. Set iron pipe flush with surface and updated ties.

September 18, 1957 - Minnesota Highway Department found iron pipe down 0.1' in centerline of Main Street. Updated ties.

November 1959 - N.C. Hoium set iron pipe and updated ties.

August 16, 1960 - Found granite monument down 4'. Set cast iron monument on top of granite and flush with surface. Updated ties.

June 29, 1964 - Found cast iron monument and updated ties.

July 20, 1966 - Found cast iron monument and updated ties.

July 23, 1970 - Found cast iron monument and updated ties. Set P.K. nails 2.00' North and East.

July 19, 1974 - Found cast iron monument and updated ties.

June 17, 1977 - Found cast iron monument and updated ties.

June 26, 1980 - Found cast iron monument and updated ties.

July 25, 1983 - Found cast iron monument and updated ties.

June 24, 1986 - Found cast iron monument and updated ties.

August 7, 1990 - Set construction (transit) ties prior to road construction.

November 27, 1990 - Set cast iron monument flush with surface after road construction using construction ties. Established temporary ties.

June 25, 1991 - Found cast iron monument and updated ties.

August 8, 1994 - Found cast iron monument and updated ties.

September 28, 2001 - Found cast iron monument and established NAD 1983 (1996 Adjustment) Anoka County Project Coordinates by Static GPS methods.

March 25, 2010 - Found cast iron monument and updated ties.