

CERTIFICATE OF LOCATION OF GOVERNMENT CORNER

County of Anoka

State of Minnesota


Northwest Corner of Sec. 7 Township 31 Range 24

On the 8th day of January, 1981, the described corner was evidenced by area resurvey

and to perpetuate the location of said corner, at the exact location thereof, a permanent marker was placed consisting of a cast iron monument

AND on the 29th day of March, 2010, said permanent marker was found and the ties were updated

Updated reference ties are as shown below.

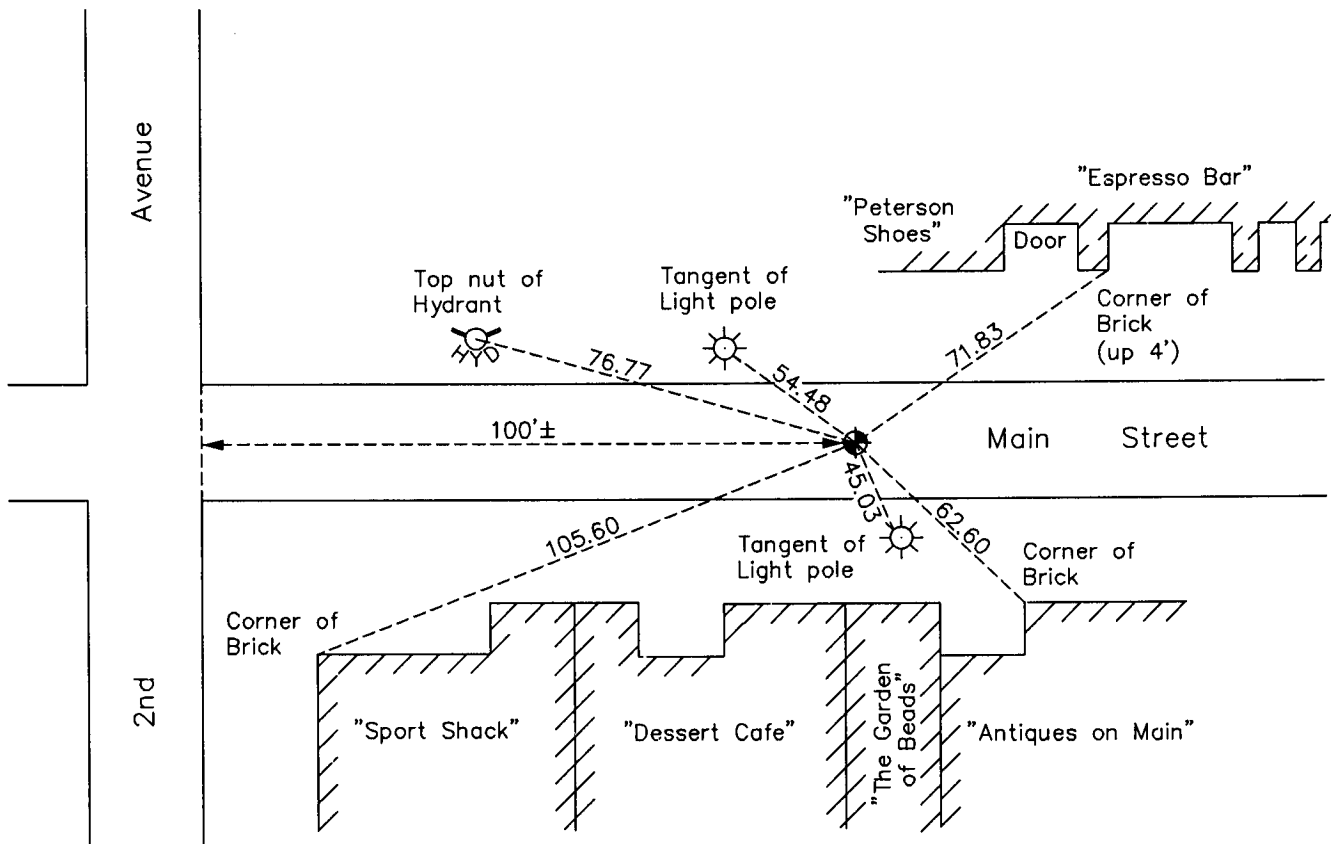

ANOKA COUNTY SURVEYOR

Revision Date

4/29/10

N.A.D. 1983 Coordinates
(1996 Adjustment)

County Project Coordinates	
Northing	159333.2524
Easting	468496.5788
Date	6/19/01

I hereby certify that this United States public land survey monument record is correct and complete to the best of my knowledge and belief.

Larry D. Hoium Date 4/29/10

Larry D. Hoium, Anoka County Surveyor

Minnesota License Number 18165

HISTORY OF GOVERNMENT CORNER

Page No. 38A

County of Anoka

State of Minnesota

Northwest Corner of Sec. 7 Township 31 Range 24

CORNER HISTORY:

January 8, 1981 - Set P.K. nail using area resurvey and established ties to monument.

July 26, 1983 - Found P.K. nail and updated ties.

August 2, 1984 - Replaced P.K. nail with a cast iron monument and set P.K. nails 2.00' north and east.
Updated ties.

June 19, 1986 - Found cast iron monument and updated ties.

August 19, 1994 - Found cast iron monument and updated ties.

June 19, 2001 - Found cast iron monument and established NAD 1983 (1996 Adjustment) Anoka County Project Coordinates by Static GPS methods.

March 29, 2010 - Found cast iron monument and updated ties.