

CERTIFICATE OF LOCATION OF GOVERNMENT CORNER

County of Anoka

State of Minnesota



East 1/4 Corner of Sec. 7 Township 31 Range 24

On the 11th day of August, 1960, the described corner was evidenced by a concrete monument

and to perpetuate the location of said corner, at the exact location thereof, a permanent marker was placed consisting of a cast iron monument

AND on the 12th day of March, 2010, said permanent marker was found and the ties were updated

Updated reference ties are as shown below.

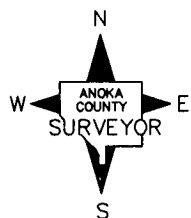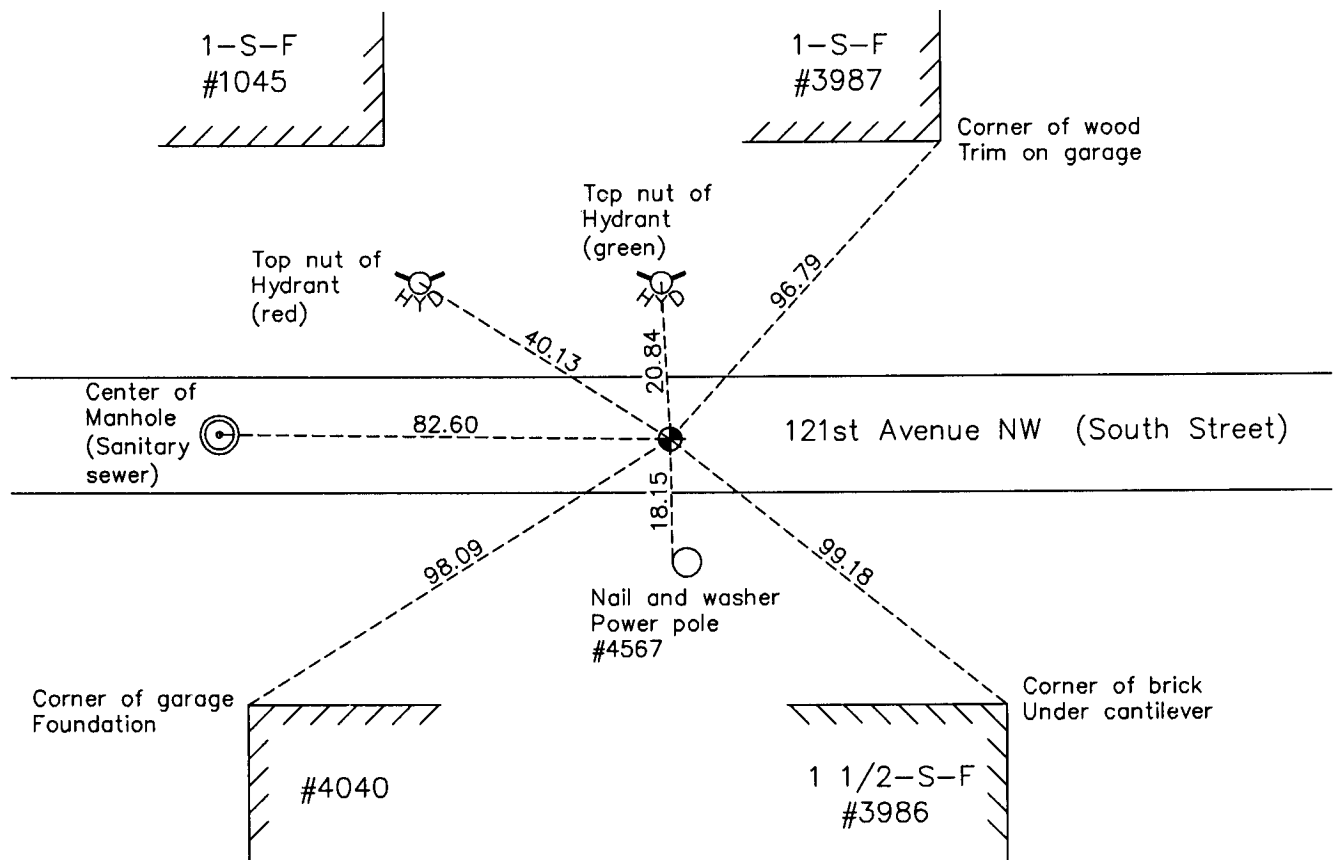

Revision Date
4/30/10

N.A.D. 1983 Coordinates
(1996 Adjustment)

County Project Coordinates	
Northing	<u>156526.1169</u>
Easting	<u>473801.2099</u>
Date	<u>8/14/01</u>

I hereby certify that this United States public land survey monument record is correct and complete to the best of my knowledge and belief.

Larry D. Hoium Date 4/30/10

Larry D. Hoium, Anoka County Surveyor

Minnesota License Number 18165

HISTORY OF GOVERNMENT CORNER

Page No. 39

County of Anoka

State of Minnesota

East 1/4 Corner of Sec. 7 Township 31 Range 24

CORNER HISTORY:

June 1, 1943 - H.A. Cartwright found concrete monument flush with surface. Established ties to monument.

August 11, 1960 - Found concrete monument flush with surface and updated ties.

September 2, 1964 - Found concrete monument flush with surface and 0.2' West of fence. Updated ties.

July 27, 1966 - Found concrete monument and updated ties.

July 23, 1970 - Found concrete monument down 0.5'± and updated ties.

July 3, 1974 - Found concrete monument and updated ties.

June 16, 1977 - Found concrete monument and updated ties.

June 30, 1980 - Found concrete monument and updated ties.

July 18, 1983 - Found concrete monument and updated ties.

June 18, 1986 - Found concrete monument and updated ties.

August 27, 1990 - Replaced concrete monument with a cast iron monument after road construction and updated ties.

August 17, 1994 - Found cast iron monument and updated ties.

August 14, 2001 - Found cast iron monument and established NAD 1983 (1996 Adjustment) Anoka County Project Coordinates by Static GPS methods. Updated ties.

March 12, 2010 - Found cast iron monument and updated ties.