

CERTIFICATE OF LOCATION OF GOVERNMENT CORNER

County of Anoka

State of Minnesota

South 1/4 Corner of Sec. 11 Township 31 Range 24



On the 22nd day of July, 1960, the described corner was evidenced by a concrete monument

and to perpetuate the location of said corner, at the exact location thereof, a permanent marker was placed consisting of the same concrete monument (up 2'±) with a sign and post on the east side

AND on the 23rd day of April, 2012, said permanent marker was found missing.

Set solid cast iron monument using construction ties and GPS coordinates and updated ties.

Updated reference ties are as shown below.

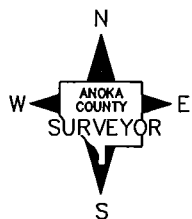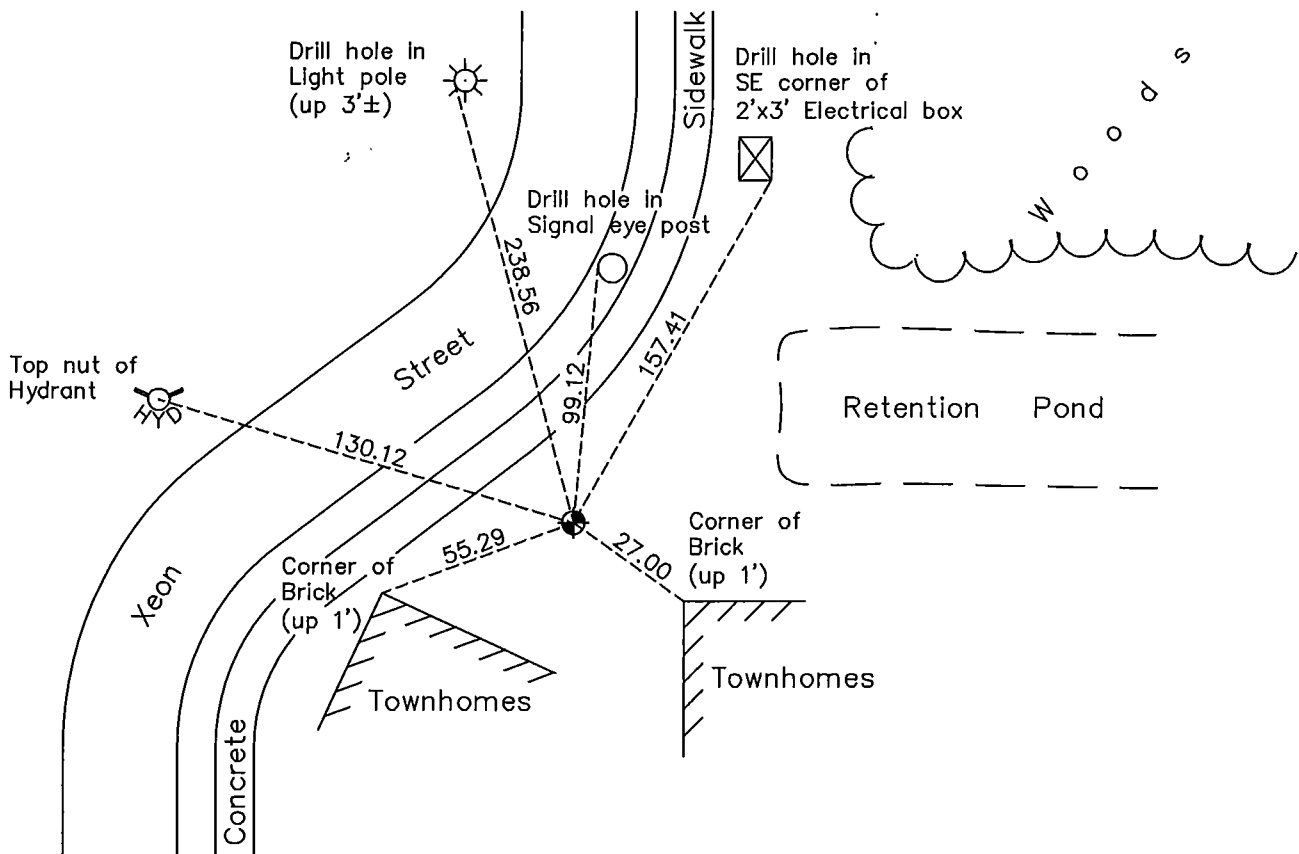

Revision Date
5/10/12

N.A.D. 1983 Coordinates
(1996 Adjustment)

County Project Coordinates	
Northing	153625.3884
Easting	492198.8074
Date	9/06/01

I hereby certify that this United States public land survey monument record is correct and complete to the best of my knowledge and belief.

Larry D. Holum Date 5/10/12

Larry D. Holum, Anoka County Surveyor

Minnesota License Number 18165

HISTORY OF GOVERNMENT CORNER

County of Anoka

State of Minnesota

South 1/4 Corner of Sec. 11 Township 31 Range 24

CORNER HISTORY:

November 26, 1943 - H.A. Cartwright found concrete monument and established ties to monument.

July 22, 1960 - Found concrete monument up 1.5'± and updated ties.

June 5, 1964 - Found concrete monument and updated ties.

July 27, 1965 - Found concrete monument and updated ties.

July 18, 1966 - Found concrete monument and updated ties.

July 27, 1970 - Found concrete monument and updated ties.

July 8, 1974 - Found concrete monument and updated ties.

June 20, 1977 - Found concrete monument and updated ties.

October 23, 1978 - Found concrete monument leaning with ties gone. Straightened monument and updated ties.

July 10, 1980 - Found concrete monument and updated ties.

June 19, 1986 - Found concrete monument and updated ties.

August 21, 1990 - Found concrete monument and set sign and post on the east side. Updated ties.

August 16, 1994 - Found concrete monument and updated ties.

September 6, 2001 - Found concrete monument and established NAD 1983 (1996 Adjustment) Anoka County Project Coordinates by Static GPS methods. Updated ties.

September 20, 2001 - Found concrete monument and updated ties.

September 29, 2005 - Found concrete monument and updated ties.

February 2010 - Found concrete monument missing. The position will be re-determined and a new monument set at a later date.

April 23, 2012 - Reset position of corner with a solid cast iron monument using construction ties (date set unknown) and GPS coordinates. Set corner half way in between tie position (0.13 north) and GPS position due to inability to determine the reason for difference. Verified position by Static GPS methods.