

# CERTIFICATE OF LOCATION OF GOVERNMENT CORNER

County of Anoka

State of Minnesota


## West 1/4 Corner of Sec. 23 Township 31 Range 24

On the 22nd day of July, 1964, the described corner was evidenced by a 1 1/2" iron pipe

and to perpetuate the location of said corner, at the exact location thereof, a permanent marker was placed consisting of a red and white 2" square steel Telspar monument with a sign attached facing West

AND on the 10th day of March, 2010, said permanent marker was found and the ties were updated

Updated reference ties are as shown below.

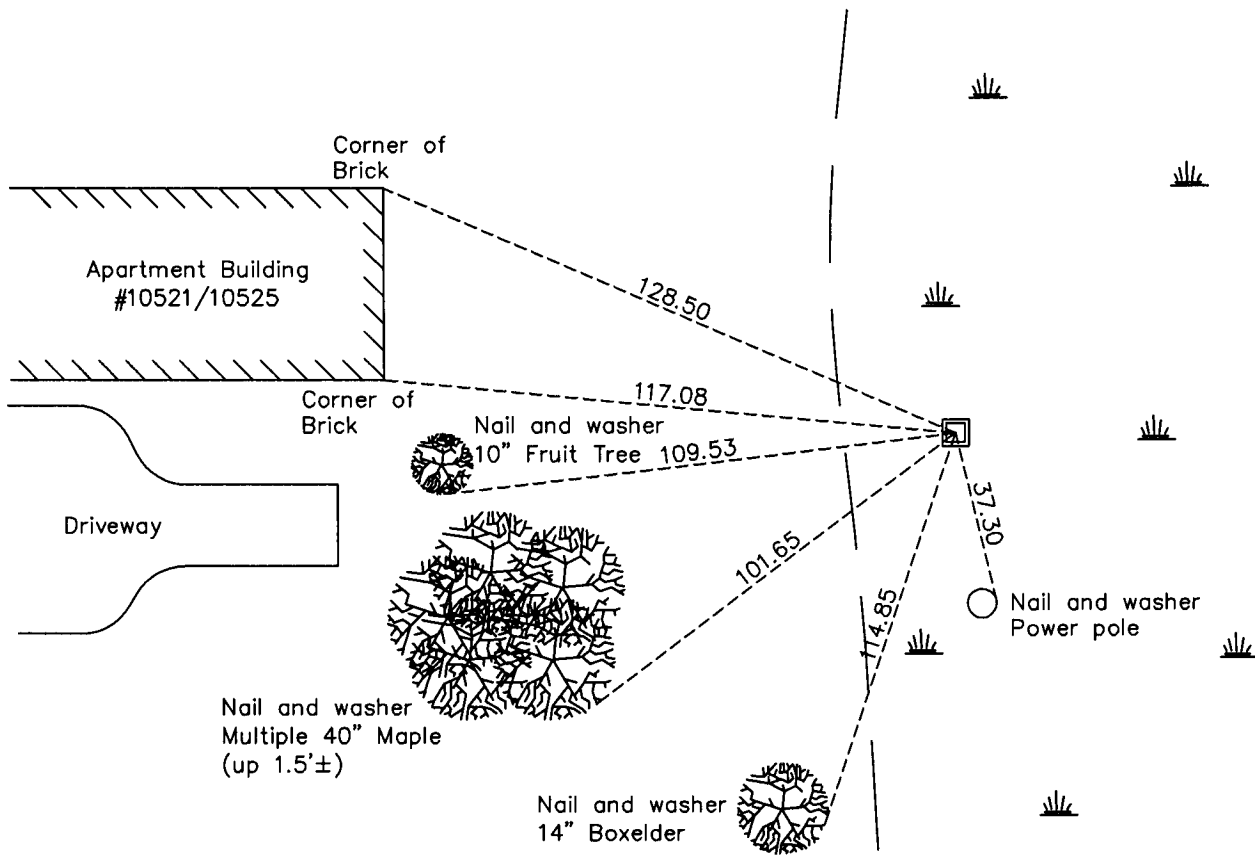

N

W ANOKA COUNTY SURVEYOR E

S

Revision Date

5/19/10

N.A.D. 1983 Coordinates  
(1996 Adjustment)

County Project Coordinates	
Northing	145809.4899
Easting	489434.5570
Date	9/24/01

I hereby certify that this United States public land survey monument record is correct and complete to the best of my knowledge and belief.

*Larry D. Hoium* Date 5/19/10

\_\_\_\_\_  
Larry D. Hoium, Anoka County Surveyor

Minnesota License Number 18165

# HISTORY OF GOVERNMENT CORNER

Page No. 75

County of Anoka

State of Minnesota

## West 1/4 Corner of Sec. 23 Township 31 Range 24

### **CORNER HISTORY:**

Summer 1957 - Minder Engineering Company found a 1-1/2" iron pipe set up 8". Established ties to monument.

December 14, 1960 - Found a 1-1/2" iron pipe set up 8"± and updated ties.

July 22, 1964 - Replaced 1-1/2" iron pipe with a 1" x 9' red and white iron pipe set up 3'. Updated ties.

July 21, 1966 - Replaced red and white iron pipe with a longer red and white iron pipe set up 3'. Updated ties.

August 3, 1970 - Found red and white iron pipe and updated ties.

July 9, 1974 - Found red and white iron pipe and updated ties.

August 1, 1974 - Found red and white iron pipe up 3'± and updated ties.

June 23, 1977 - Found red and white iron pipe and updated ties.

March 24, 1987 - Replaced bent red and white iron pipe with a new red and white iron pipe. Updated ties.

August 31, 1990 - Found red and white iron pipe and updated ties.

August 21, 1994 - Found red and white iron pipe and updated ties.

September 24, 2001 - Found red and white iron pipe and established NAD 1983 (1996 Adjustment) Anoka County Project Coordinates by Static GPS methods. Updated ties.

March 10, 2010 - Found a red and white 2" square steel Telspar monument (date set unknown) with a sign attached facing west and updated ties.