

# CERTIFICATE OF LOCATION OF GOVERNMENT CORNER

County of Anoka

State of Minnesota



Witness Corner of Sec. 28 Township 31 Range 24  
(on east line of section)

On the 19th day of June, 1975, the described corner was evidenced by a stone  
monument

and to perpetuate the location of said corner, at the exact location thereof, a permanent marker  
was placed consisting of a cast iron monument on top of the stone monument

AND on the \_\_\_\_ day of March, 2010, said permanent marker was found down 0.5' with a  
sign and post 0.6' North and the ties were updated

Updated reference ties are as shown below.

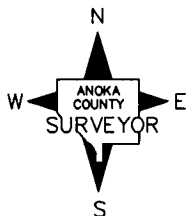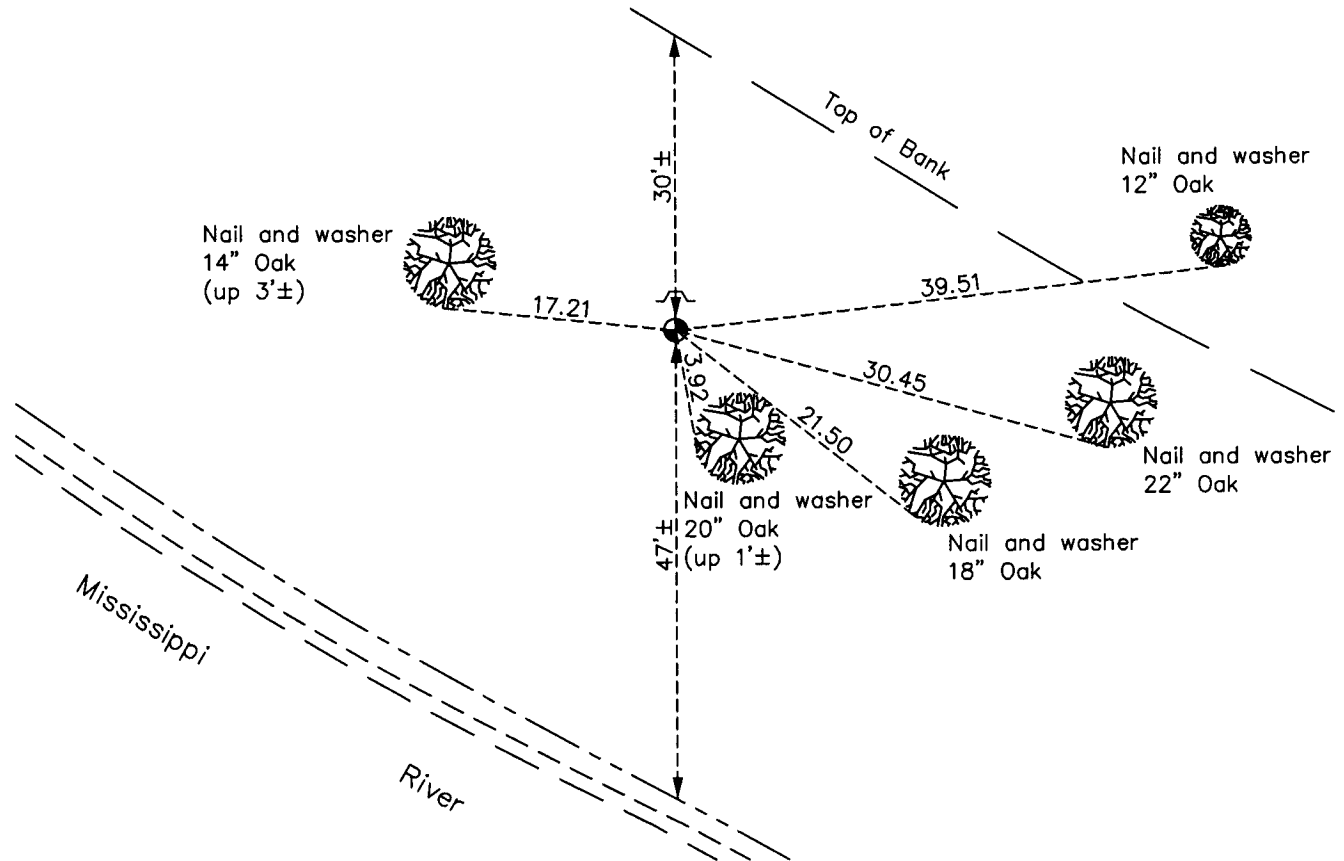

Revision Date  
5/24/10

N.A.D. 1983 Coordinates  
(1996 Adjustment)

County Project Coordinates	
Northing	143168.7225
Easting	484051.0206
Date	10/31/01

I hereby certify that this United States public land survey monument record is correct and complete to the best of my knowledge and belief.

*Larry D. Hoium* Date 5/24/10  
 Larry D. Hoium, Anoka County Surveyor  
 Minnesota License Number 18165

# HISTORY OF GOVERNMENT CORNER

Page No. 85

County of Anoka

State of Minnesota

Witness Corner of Sec. 28 Township 31 Range 24  
(on east line of section)

## **CORNER HISTORY:**

**June 19, 1975** - Set cast iron monument over stone monument found per testimony of resident to west (Mrs. Locken). Resident to east was Northern States Power Company, now Hennepin County. Set sign and post 1'± north of monument and updated ties.

**June 24, 1977** - Found cast iron monument and updated ties.

**July 9, 1980** - Found cast iron monument and updated ties.

**July 26, 1983** - Found cast iron monument and updated ties.

**June 23, 1986** - Found cast iron monument and updated ties.

**May 2, 1991** - Found cast iron monument and updated ties.

**August 24, 1994** - Found cast iron monument and updated ties.

**October 31, 2001** - Found cast iron monument and established NAD 1983 (1996 Adjustment) Anoka County Project Coordinates by Static GPS methods. Updated ties.

**March 2010** - Found cast iron monument down 0.5' with a sign and post 0.6' north and updated ties.