

CERTIFICATE OF LOCATION OF GOVERNMENT CORNER

County of Anoka

State of Minnesota


West 1/4 Corner of Sec. 26 Township 31 Range 24

On the 5th day of January, 1966, the described corner was evidenced by a 1/2" iron pipe set by Suburban Engineering

and to perpetuate the location of said corner, at the exact location thereof, a permanent marker was placed consisting of a cast iron monument with a sign and post on the north side

AND on the 18th day of February, 2010, said permanent marker was found down 1.2' and the ties were updated

Updated reference ties are as shown below.

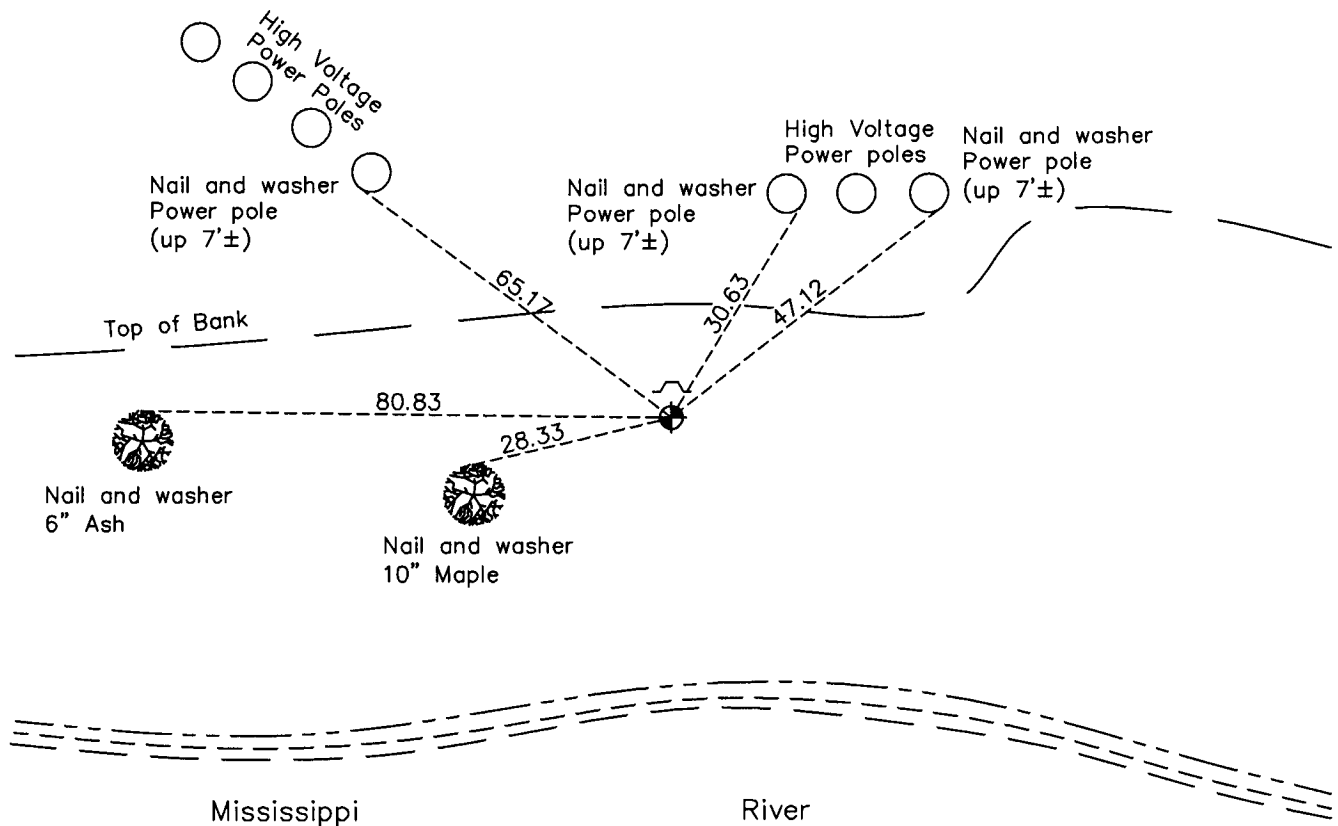

N

S

ANOKA COUNTY SURVEYOR

Revision Date

5/24/10

N.A.D. 1983 Coordinates
(1996 Adjustment)

| County Project Coordinates | |
|----------------------------|-------------|
| Northing | 140413.3148 |
| Easting | 489342.1285 |
| Date | 10/10/01 |

I hereby certify that this United States public land survey monument record is correct and complete to the best of my knowledge and belief.

Larry D. Hoium Date 5/24/10

Larry D. Hoium, Anoka County Surveyor

Minnesota License Number 18165

HISTORY OF GOVERNMENT CORNER

Page No. 86

County of Anoka

State of Minnesota

West 1/4 Corner of Sec. 26 Township 31 Range 24

CORNER HISTORY:

July 6, 1943 - H.A. Cartwright found concrete monument. Established ties to monument. The field notes for this monument label it as a Meander corner on the west line of the section.

April 17, 1964 - Found 1/2" iron pipe up 0.2' and believed to be set by Suburban Engineering using one tie to a 10" Willow. This iron pipe measures 136'± to a 24" Cottonwood, possibly Cartwright's 128.8' S 77° 24'E tie to a 12" Cottonwood. There was no evidence of additional Cartwright ties. Updated ties.

January 5, 1966 - Found 1/2" iron pipe and updated ties.

July 15, 1966 - Replaced 1/2" iron pipe with a cast iron monument set flush with the surface. Updated ties. There is a 2" iron pipe 4.7'± east of cast iron monument.

July 31, 1970 - Found cast iron monument and updated ties.

July 7, 1974 - Found cast iron monument and updated ties.

June 24, 1977 - Found cast iron monument and updated ties.

June 17, 1986 - Found cast iron monument and updated ties.

August 30, 1990 - Found cast iron monument and updated ties.

August 15, 1994 - Found cast iron monument and updated ties.

October 10, 2001 - Found cast iron monument and established NAD 1983 (1996 Adjustment) Anoka County Project Coordinates by Static GPS methods. Updated ties.

February 18, 2010 - Found cast iron monument down 1.2' and updated ties. A sign and post was found on the north side of monument.