

CERTIFICATE OF LOCATION OF GOVERNMENT CORNER

County of Anoka

State of Minnesota

East 1/4 Corner of Sec. 26 Township 31 Range 24


On the 8th day of August, 1960, the described corner was evidenced by a concrete monument


and to perpetuate the location of said corner, at the exact location thereof, a permanent marker was placed consisting of a red and white iron pipe with a sign and post

AND on the 14th day of February, 2011, said permanent marker was found broken off. A 4' section of 2" sq. steel Telspar with a 'County Surveyor' cap was added to the existing monument.

Updated reference ties are as shown below.

C.S.A.H. No. 3 (Coon Rapids Blvd.) (eastbound lanes)

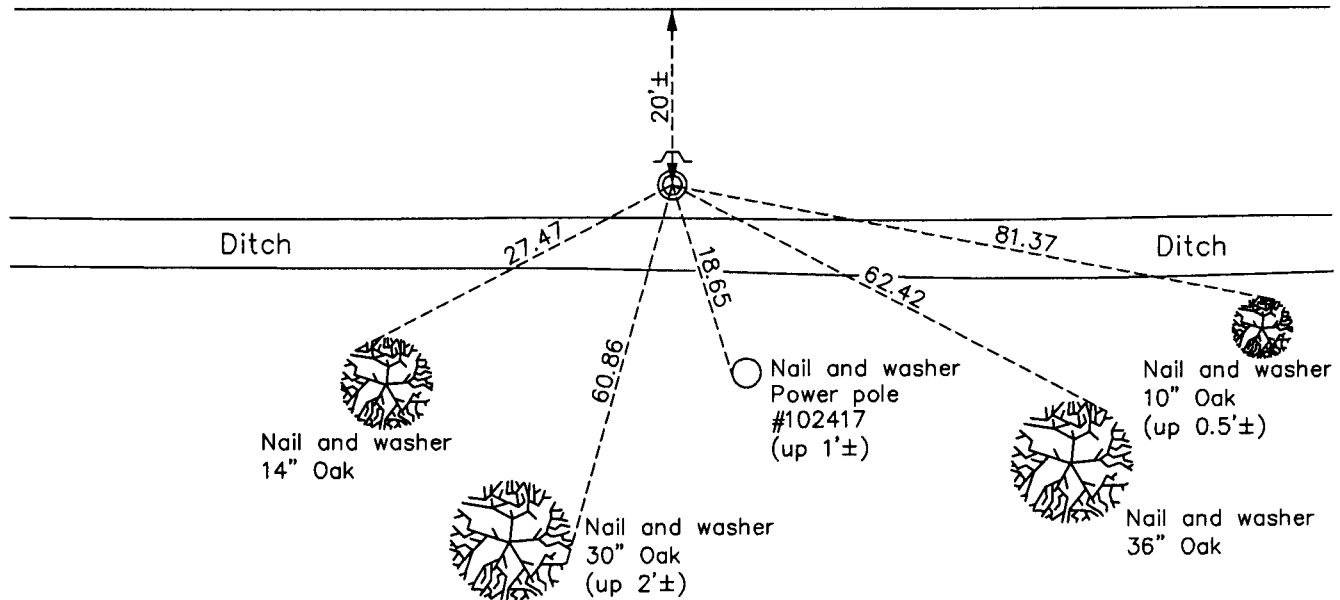

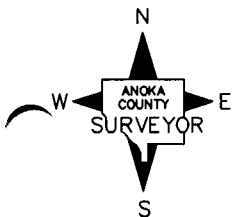

ANOKA COUNTY SURVEYOR

Revision Date 3/08/11

N.A.D. 1983 Coordinates
(1996 Adjustment)

County Project Coordinates	
Northing	140398.7603
Easting	494703.4548
Date	10/23/01

I hereby certify that this United States public land survey monument record is correct and complete to the best of my knowledge and belief.

Larry D. Hoium Date 3/08/11

Larry D. Hoium, Anoka County Surveyor

Minnesota License Number 18165

HISTORY OF GOVERNMENT CORNER

Page No. 87

County of Anoka

State of Minnesota

East 1/4 Corner of Sec. 26 Township 31 Range 24

CORNER HISTORY:

July 19, 1943 - H.A. Cartwright found concrete monument set flush with the surface. Established ties to monument.

August 8, 1960 - Found concrete monument with a 3" iron post up 6.5' on north side and updated ties.

June 17, 1964 - Found concrete monument and updated ties.

July 11, 1966 - Found concrete monument and updated ties.

August 4, 1970 - Found concrete monument and updated ties.

July 1971 - Found area under construction and updated ties to corner position. Type of monument found was not recorded.

July 16, 1974 - Found red and white iron pipe up 4'± with a sign and updated ties.

June 24, 1977 - Found red and white iron pipe and updated ties.

July 7, 1980 - Found red and white iron pipe and updated ties.

June 18, 1986 - Found red and white iron pipe and updated ties.

April 25, 1988 - Found red and white iron pipe and updated ties.

August 29, 1990 - Found red and white iron pipe with a sign and post and updated ties.

August 15, 1994 - Found red and white iron pipe and updated ties.

October 23, 2001 - Found red and white iron pipe and established NAD 1983 (1996 Adjustment) Anoka County Project Coordinates by Static GPS methods. Updated ties.

February 14, 2011 - Found red and white iron pipe broken off. A 4' section of 2" square steel Telspar with a 'County Surveyor' cap was added to the remainder of the existing monument. Updated ties.