

CERTIFICATE OF LOCATION OF GOVERNMENT CORNER

County of Anoka

State of Minnesota


South $\frac{1}{4}$ Corner of Sec. 25 Township 31 Range 24

On the 4th day of December, 1964, the described corner was evidenced by a concrete monument

and to perpetuate the location of said corner, at the exact location thereof, a permanent marker was placed consisting of a cast iron monument

AND on the 17th day of March, 2010, said permanent marker was found down 0.1' and the ties were updated

Updated reference ties are as shown below.

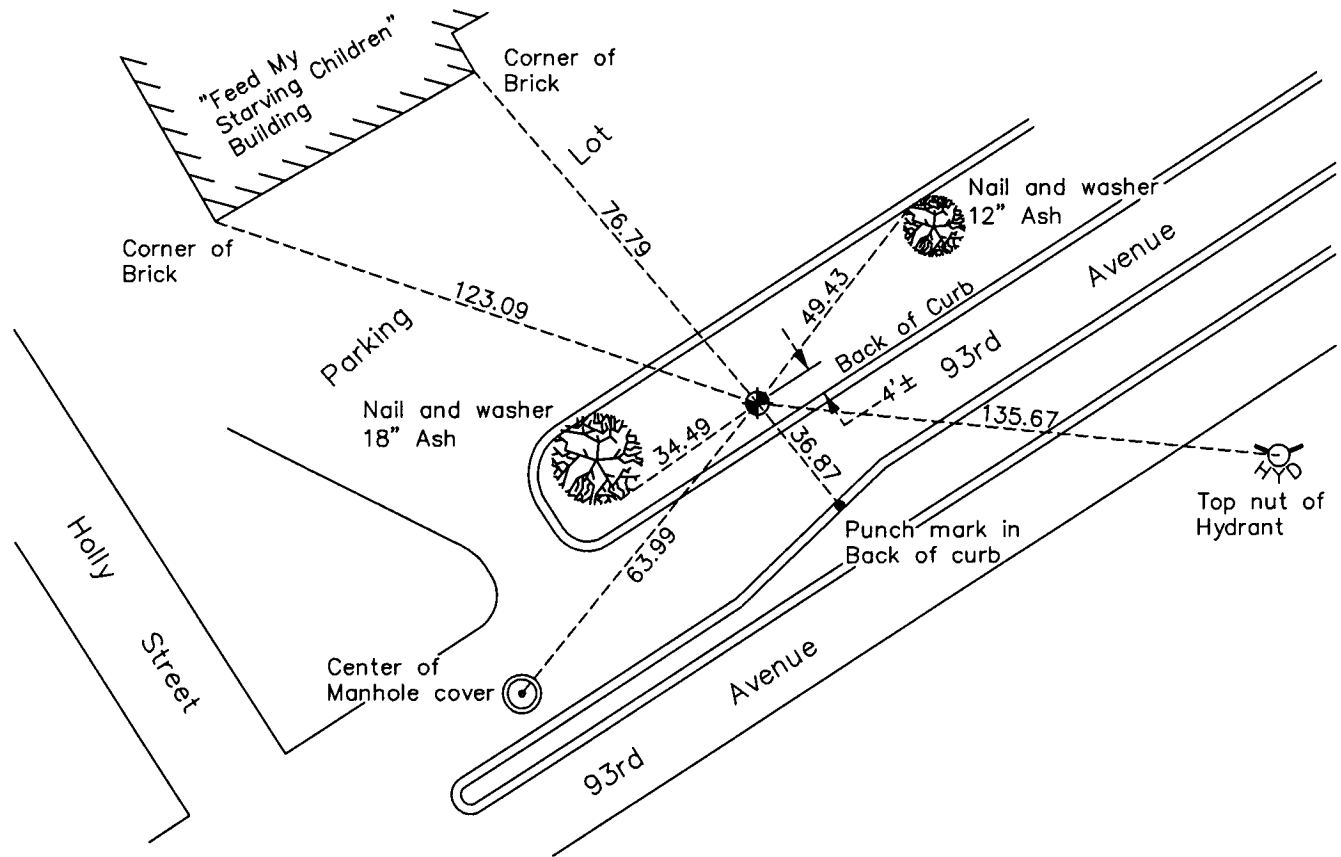

N

S

ANOKA COUNTY SURVEYOR

Revision Date

5/25/10

N.A.D. 1983 Coordinates
(1996 Adjustment)

County Project Coordinates	
Northing	137791.0168
Easting	497296.8235
Date	9/14/01

I hereby certify that this United States public land survey monument record is correct and complete to the best of my knowledge and belief.

Larry D. Hoium Date 5/25/10

Larry D. Hoium, Anoka County Surveyor

Minnesota License Number 18165

HISTORY OF GOVERNMENT CORNER

Page No. 90

County of Anoka

State of Minnesota

South 1/4 Corner of Sec. 25 Township 31 Range 24

CORNER HISTORY:

November 27, 1944 - H.A. Cartwright found concrete monument set flush with the surface. Established ties to monument.

August 11, 1960 - Found concrete monument up 0.3' with an iron pipe up 1.5' on east and west side. Updated ties.

December 4, 1964 - Found concrete monument leaning over. Straightened it to determine position and replaced it with a cast iron monument set up 0.1'. Set steel fence posts 0.5' east and west of monument and updated ties.

July 12, 1966 - Found cast iron monument and updated ties.

August 5, 1970 - Lowered cast iron monument down 1.0'± and set construction ties prior to road construction.

September 5, 1972 - Found cast iron monument down 1.4'± fitting construction ties. Set sign and post 0.5'± NW of monument and updated ties.

July 18, 1974 - Found cast iron monument and updated ties.

June 24, 1977 - Found cast iron monument and updated ties.

June 30, 1980 - Found cast iron monument down 1.3' and updated ties.

June 13, 1986 - Found cast iron monument and updated ties.

February 1, 1988 - Found cast iron monument and updated ties.

August 16, 1990 - Found cast iron monument and updated ties.

August 15, 1994 - Found cast iron monument and updated ties.

September 14, 2001 - Found cast iron monument and established NAD 1983 (1996 Adjustment) Anoka County Project Coordinates by Static GPS methods.

March 17, 2010 - Found cast iron monument down 0.1' and updated ties.