

CERTIFICATE OF LOCATION OF GOVERNMENT CORNER

County of Anoka

State of Minnesota

Witness Corner of Sec. 26 Township 31 Range 24


(On south line of SE1/4)

On the 28th day of September, 1987, the described corner was evidenced by area resurvey

and to perpetuate the location of said corner, at the exact location thereof, a permanent marker was placed consisting of a cast iron monument

AND on the 5th day of March, 2010, said permanent marker was found and the ties were updated

Updated reference ties are as shown below.

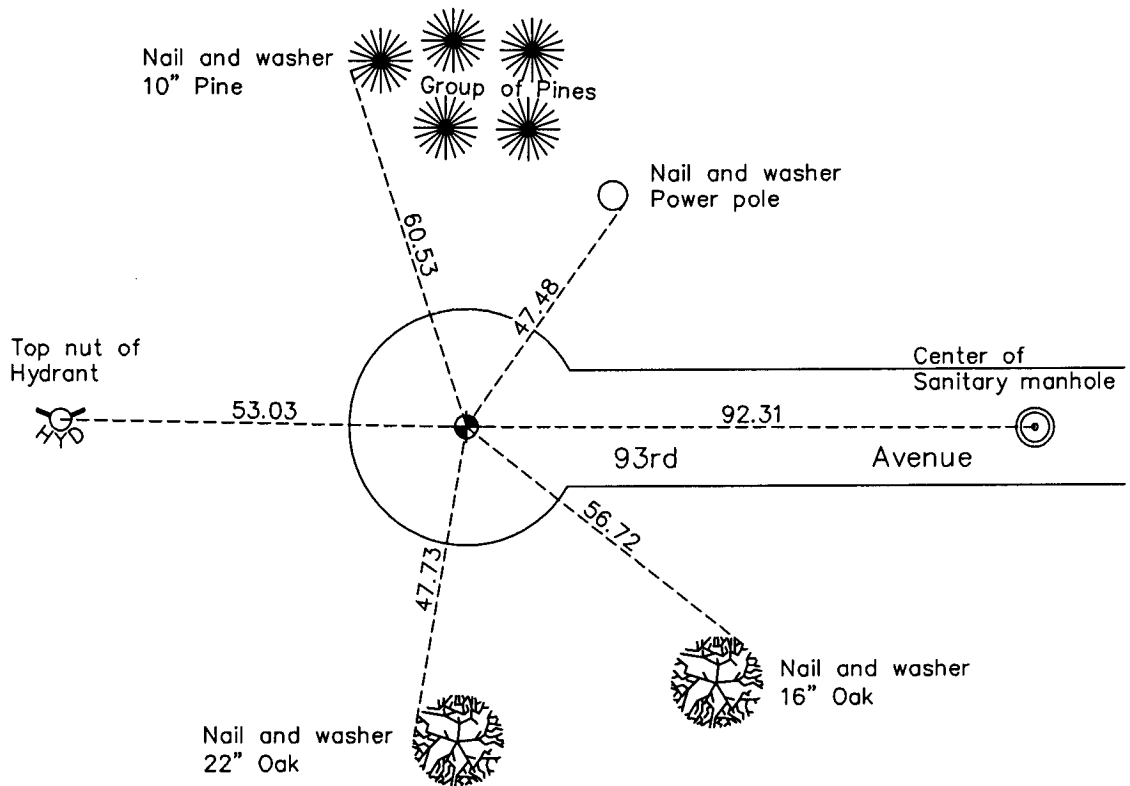

Revision Date

5/25/10

N.A.D. 1983 Coordinates
(1996 Adjustment)

| County Project Coordinates | |
|----------------------------|-------------|
| Northing | 137804.5830 |
| Easting | 492491.4415 |
| Date | 8/16/01 |

I hereby certify that this United States public land survey monument record is correct and complete to the best of my knowledge and belief.

Larry D. Hoium Date 5/25/10

Larry D. Hoium, Anoka County Surveyor

Minnesota License Number 18165

HISTORY OF GOVERNMENT CORNER

Page No. 91A

County of Anoka

State of Minnesota

Witness Corner of Sec. 26 Township 31 Range 24
(On south line of SE1/4)

CORNER HISTORY:

September 28, 1987 - Set 1/2" iron pipe using area resurvey and established ties to monument.

August 16, 1990 - Found 1/2" iron pipe and updated ties.

September 19, 1990 - Replaced 1/2" iron pipe with a cast iron monument and updated ties.

August 15, 1994 - Found cast iron monument and updated ties.

August 16, 2001 - Found cast iron monument and established NAD 1983 (1996 Adjustment) Anoka County Project Coordinates by Static GPS methods. Updated ties.

March 5, 2010 - Found cast iron monument and updated ties.