

CERTIFICATE OF LOCATION OF GOVERNMENT CORNER

County of Anoka

State of Minnesota



North 1/4 Corner of Sec. 32 Township 34 Range 23

On the 31st day of May, 1960, the described corner was evidenced by a chisel mark

and to perpetuate the location of said corner, at the exact location thereof, a permanent marker was placed consisting of a cast iron monument

AND on the 7th day of August, 2012, said permanent marker was found down 1'± under concrete. Set 11" slim CIM w/ regular top on top of found CIM after road const. & updated ties.

Updated reference ties are as shown below.

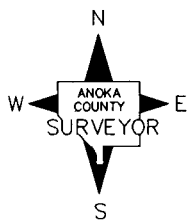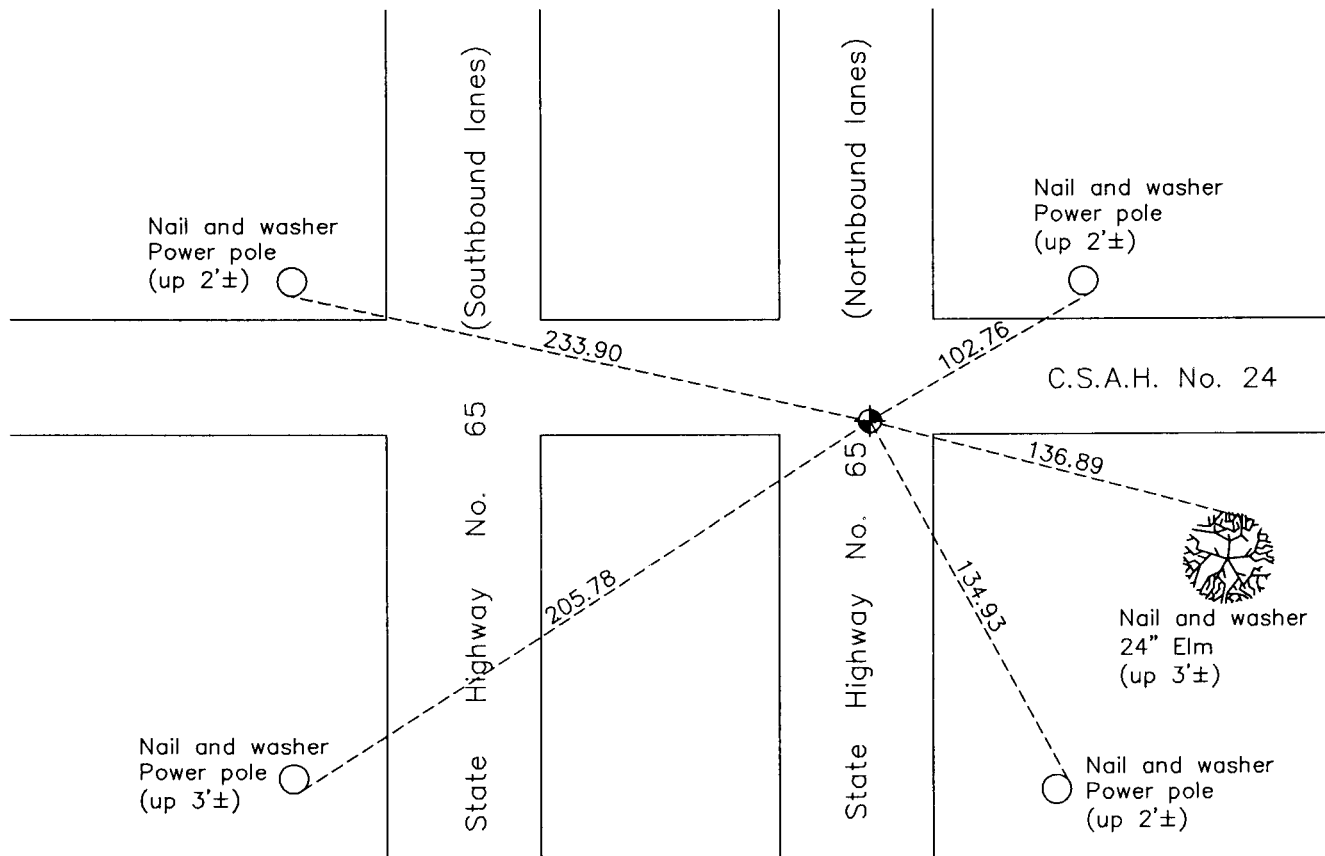

Revision Date
12/17/12

N.A.D. 1983 Coordinates
(1996 Adjustment)

County Project Coordinates	
Northing	232726.0562
Easting	508216.4947
Date	9/20/06

I hereby certify that this United States public land survey monument record is correct and complete to the best of my knowledge and belief.

Larry D. Hoium Date 12/17/12
 Larry D. Hoium, Anoka County Surveyor
 Minnesota License Number 18165