

CERTIFICATE OF LOCATION OF GOVERNMENT CORNER

County of Anoka

State of Minnesota



Northeast Corner of Sec. 1 Township 33 Range 24

On the 7th day of April, 1969, the described corner was evidenced by area resurvey

and to perpetuate the location of said corner, at the exact location thereof, a permanent marker was placed consisting of a cast iron monument (down 3.5'±)

AND on the 21st day of July, 2011, said permanent marker was found flush with the surface and the ties were updated

Updated reference ties are as shown below.

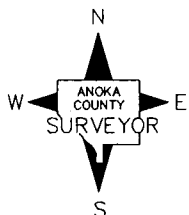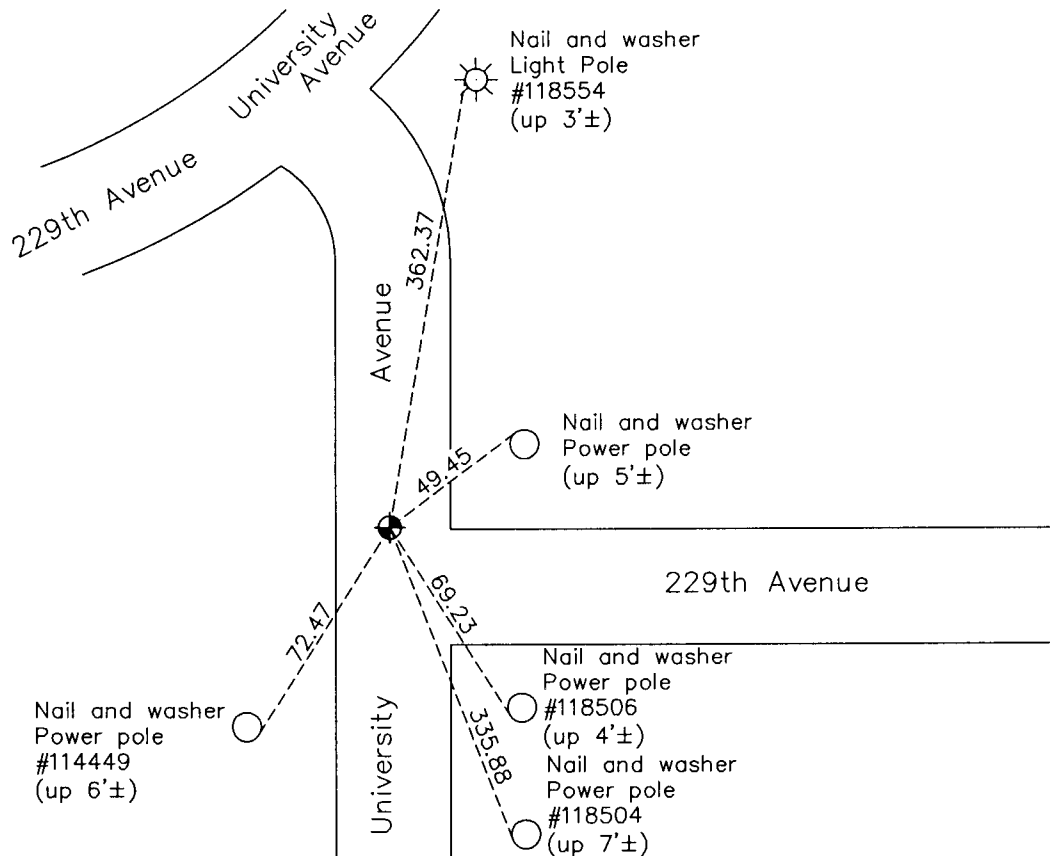

N.A.D. 1983 Coordinates
(1996 Adjustment)

| County Project Coordinates | |
|----------------------------|--------------------|
| Northing | <u>227444.2341</u> |
| Easting | <u>500342.5301</u> |
| Date | <u>2/23/01</u> |

Revision Date
11/30/11

I hereby certify that this United States public land survey monument record is correct and complete to the best of my knowledge and belief.

Larry D. Hoium Date 11/30/11

Larry D. Hoium, Anoka County Surveyor

Minnesota License Number 18165