

CERTIFICATE OF LOCATION OF GOVERNMENT CORNER

County of Anoka

State of Minnesota

Northwest Corner of Sec. 2 Township 33 Range 24



On the 10th day of December, 1970, the described corner was evidenced by area resurvey

and to perpetuate the location of said corner, at the exact location thereof, a permanent marker was placed consisting of a cast iron monument

AND on the 6th day of September, 2011, said permanent marker was found missing.

Set new cast iron monument and updated ties on March 26, 2012.

Updated reference ties are as shown below.

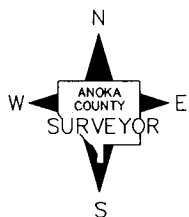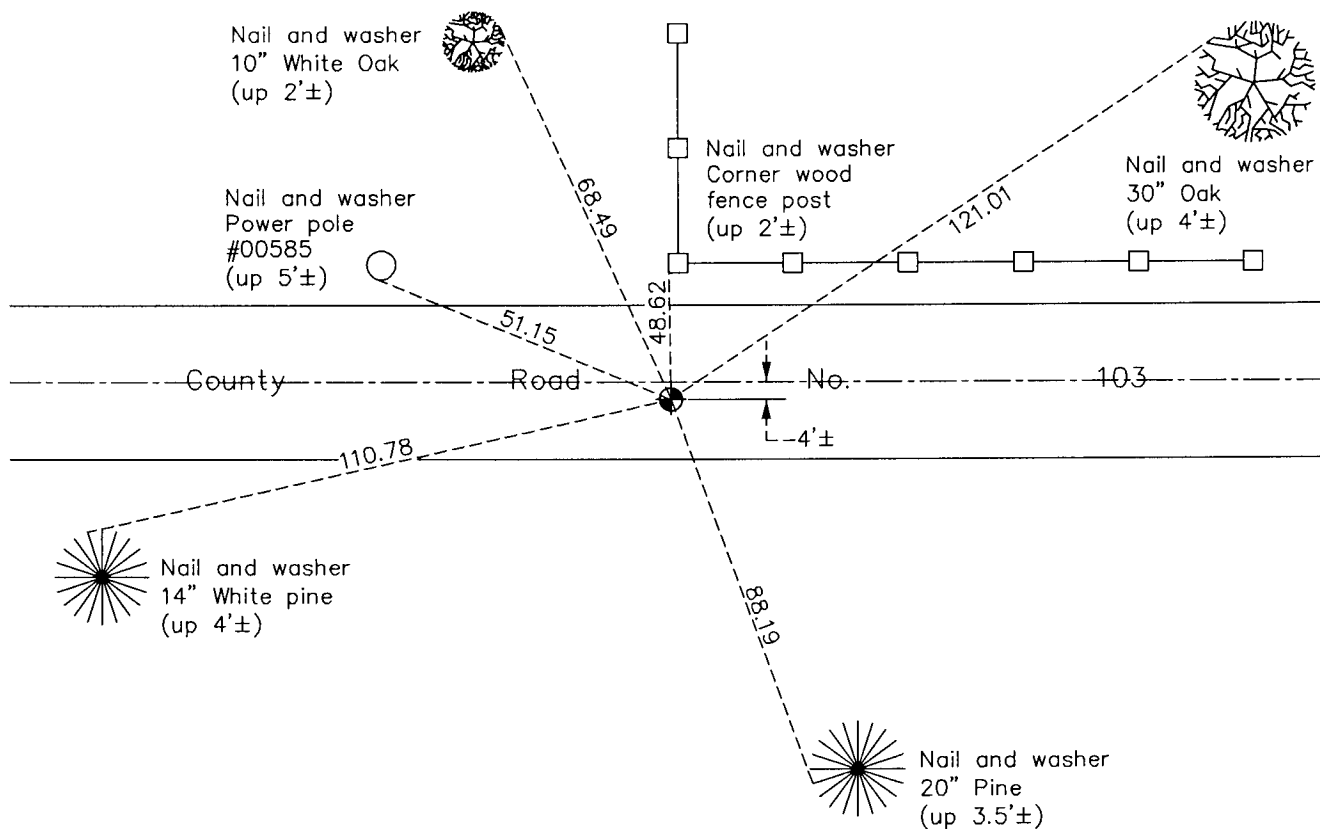

Revision Date
4/18/12

N.A.D. 1983 Coordinates
(1996 Adjustment)

County Project Coordinates	
Northing	<u>227431.5711</u>
Easting	<u>489798.8609</u>
Date	<u>3/20/01</u>

I hereby certify that this United States public land survey monuments record is correct and complete to the best of my knowledge and belief.

Larry D. Hoium Date 4/18/12

Larry D. Hoium, Anoka County Surveyor

Minnesota License Number 18165