

CERTIFICATE OF LOCATION OF GOVERNMENT CORNER

County of Anoka

State of Minnesota

Meander Corner of Sec. 5 Township 33 Range 24



(on north line of section east of Rum River)

On the 23rd day of May, 1961, the described corner was evidenced by a solid iron bar

and to perpetuate the location of said corner, at the exact location thereof, a permanent marker was placed consisting of a cast iron monument with a sign and post on the north side

AND on the 12th day of January, 2012, said permanent marker was found and the ties
were updated

Updated reference ties are as shown below.

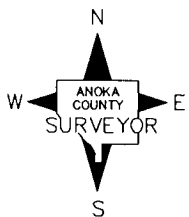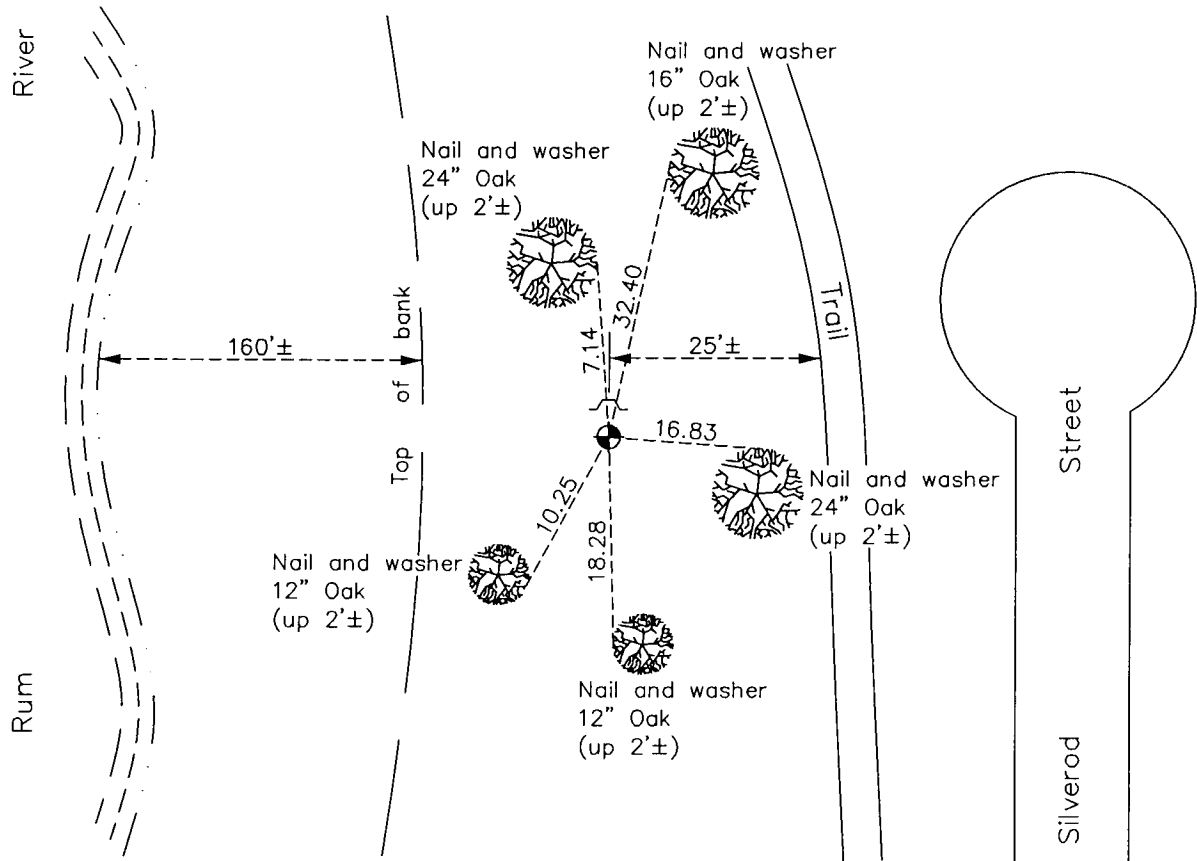

N.A.D. 1983 Coordinates
(1996 Adjustment)

County Project Coordinates

Northing 227460.7456

Easting 476958.5562

Date 4/24/01

Revision Date

5/30/12

I hereby certify that this United States public land survey monument record is correct and complete to the best of my knowledge and belief.

Larry D. Hoium Date 5/30/12

Larry D. Hoium, Anoka County Surveyor

Minnesota License Number 18165