

CERTIFICATE OF LOCATION OF GOVERNMENT CORNER

County of Anoka

State of Minnesota



Meander Corner of Sec. 5 Township 33 Range 24
 (on north line of section west of Rum River)

On the 23rd day of May, 1961, the described corner was evidenced by a 2" iron pipe

and to perpetuate the location of said corner, at the exact location thereof, a permanent marker was placed consisting of a cast iron monument

AND on the 18th day of January, 2012, said permanent marker was found down 0.2'± and the ties were updated. On April 2, 2012 set sign and post on north side.

Updated reference ties are as shown below.

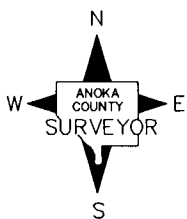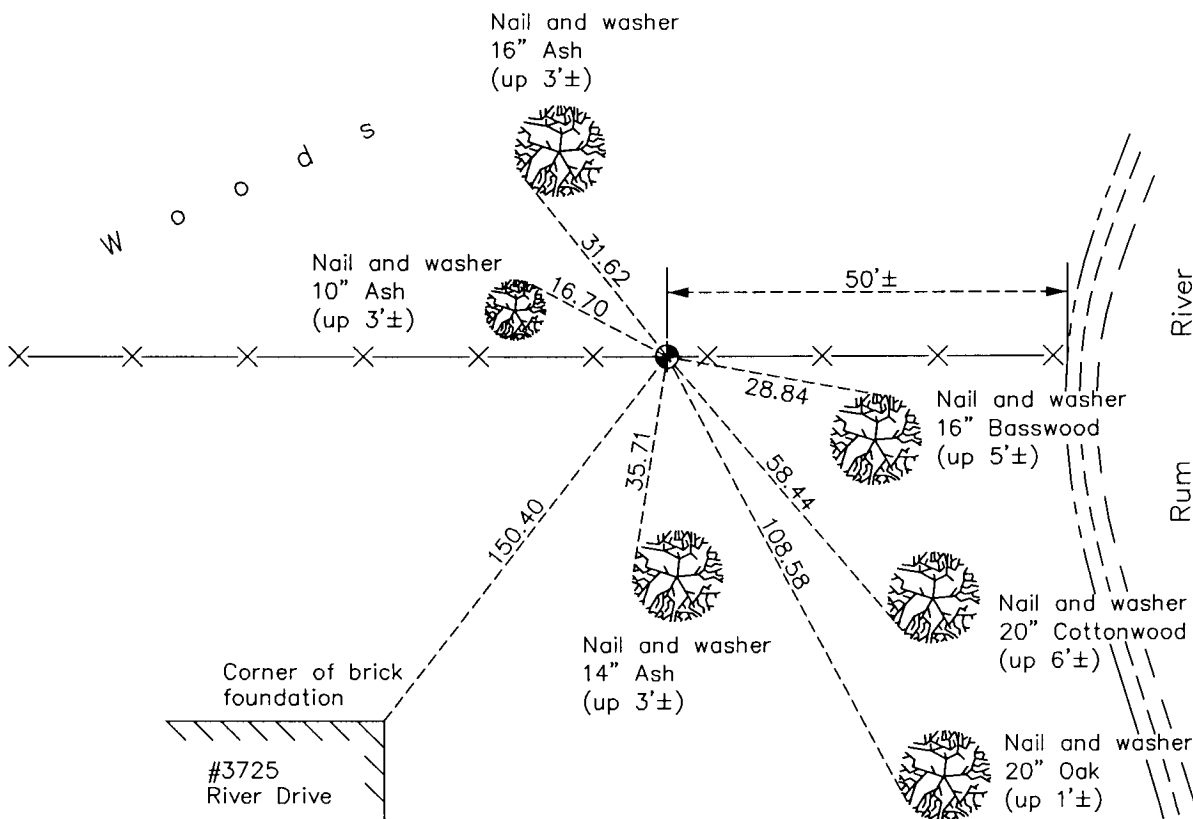

Revision Date
5/31/12

N.A.D. 1983 Coordinates
 (1996 Adjustment)

County Project Coordinates	
Northing	227462.1126
Easting	476581.2748
Date	4/26/01

I hereby certify that this United States public land survey monument record is correct and complete to the best of my knowledge and belief.

Larry D. Hoium Date 5/31/12

Larry D. Hoium, Anoka County Surveyor
 Minnesota License Number 18165