

CERTIFICATE OF LOCATION OF GOVERNMENT CORNER

County of Anoka

State of Minnesota



Northwest Corner of Sec. 6 Township 33 Range 24

On the 19th day of August, 1960, the described corner was evidenced by an 8" X 8" granite monument

and to perpetuate the location of said corner, at the exact location thereof, a permanent marker was placed consisting of a red and white 2" square steel Telspar monument with a sign attached to the south side

AND on the 13th day of January, 2012, said permanent marker was found and the ties were updated

Updated reference ties are as shown below.

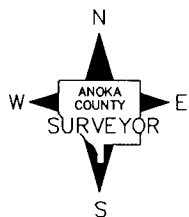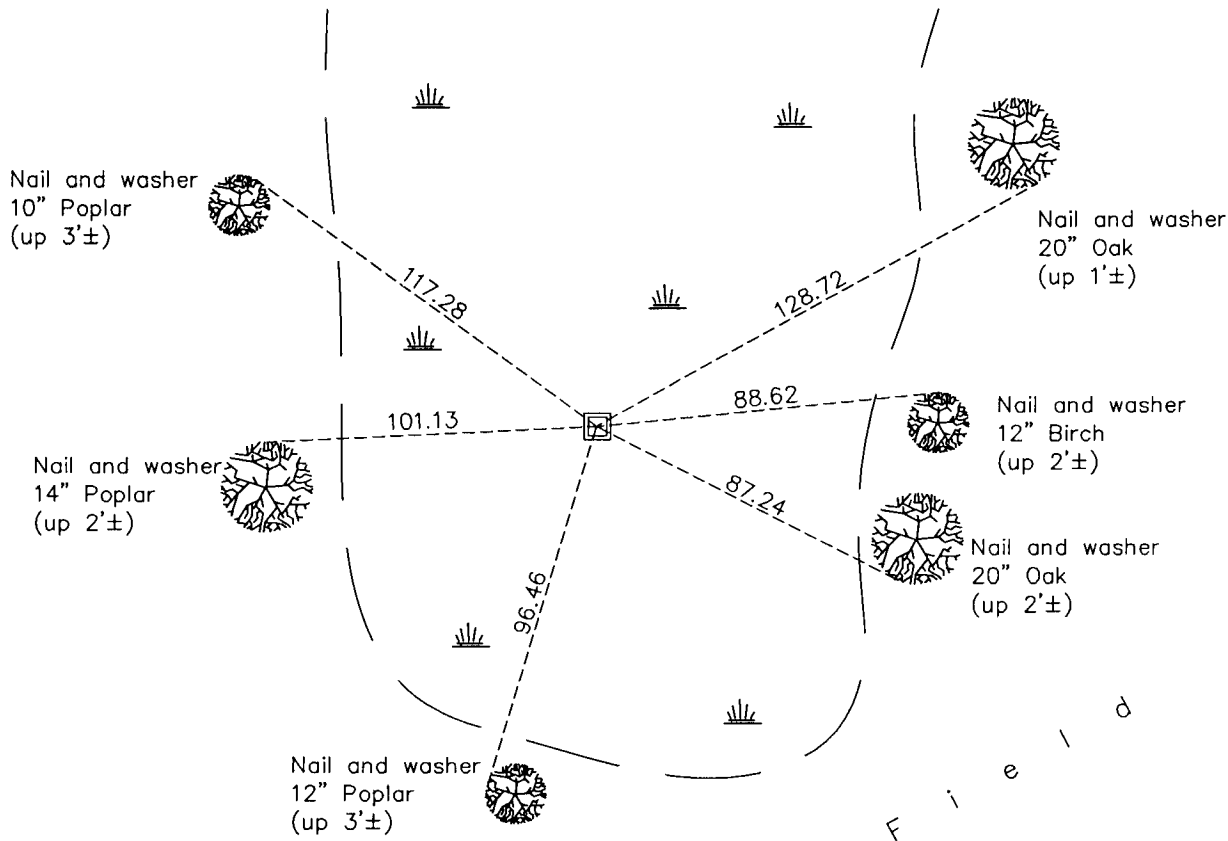

Revision Date
6/04/12

N.A.D. 1983 Coordinates
(1996 Adjustment)

County Project Coordinates	
Northing	227470.9663
Easting	468690.4389
Date	5/08/01

I hereby certify that this United States public land survey monument record is correct and complete to the best of my knowledge and belief.

Larry D. Hoium Date 6/04/12
 Larry D. Hoium, Anoka County Surveyor
 Minnesota License Number 18165