

CERTIFICATE OF LOCATION OF GOVERNMENT CORNER

County of Anoka

State of Minnesota


Witness Corner of Sec. 6 Township 33 Range 24
 (on west line of section)

On the 15th day of June, 1967, the described corner was evidenced by area resurvey

and to perpetuate the location of said corner, at the exact location thereof, a permanent marker was placed consisting of a cast iron monument

AND on the 12th day of January, 2012, said permanent marker was found down 0.5'± and the ties were updated

Updated reference ties are as shown below.

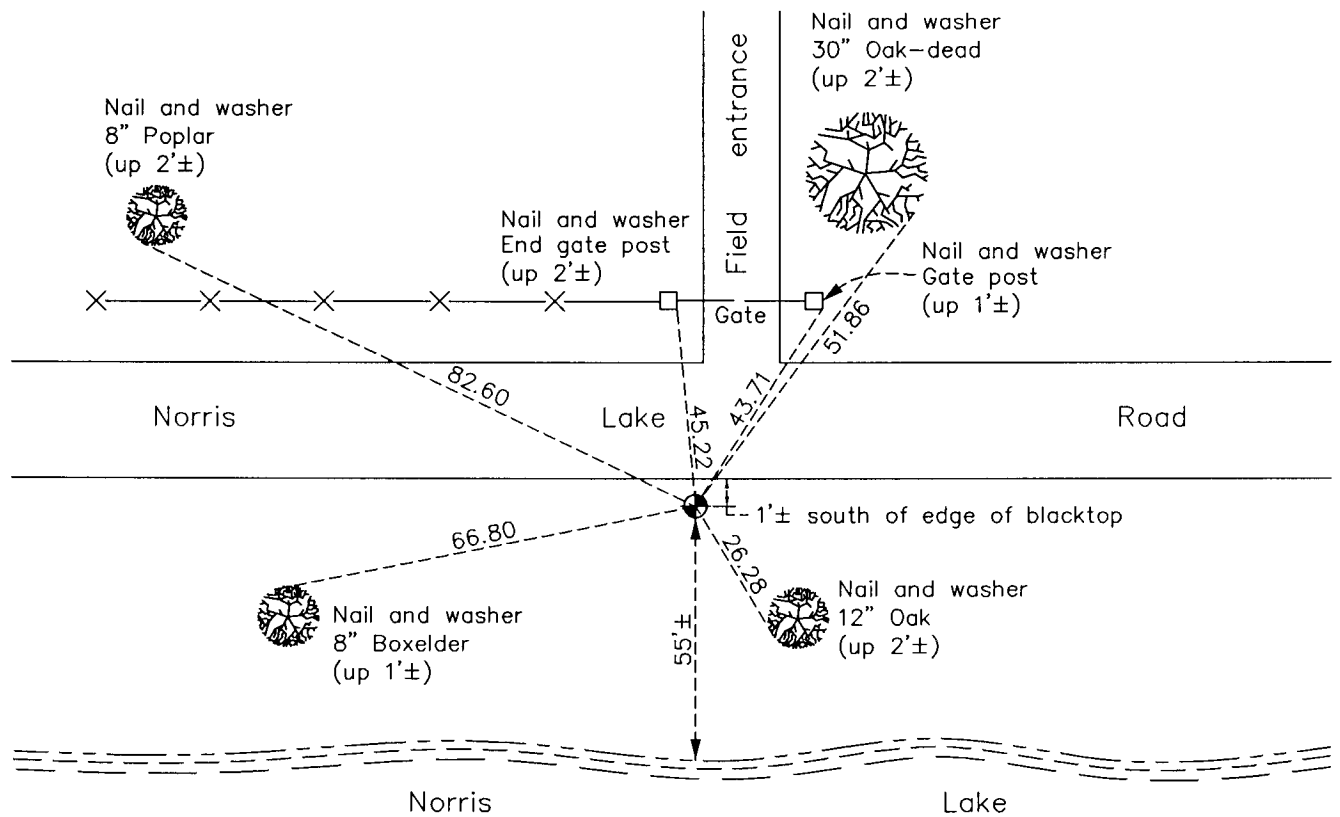

N
W ANOKA COUNTY SURVEYOR E
S

Revision Date
6/04/12

N.A.D. 1983 Coordinates
(1996 Adjustment)

County Project Coordinates	
Northing	225806.9232
Easting	468675.2346
Date	4/20/01

I hereby certify that this United States public land survey monument record is correct and complete to the best of my knowledge and belief.

Larry D. Hoium Date 6/04/12
 Larry D. Hoium, Anoka County Surveyor
 Minnesota License Number 18165