

CERTIFICATE OF LOCATION OF GOVERNMENT CORNER

County of Anoka

State of Minnesota



West 1/4 Corner of Sec. 3 Township 33 Range 24

On the 8th day of December, 1970, the described corner was evidenced by area resurvey

and to perpetuate the location of said corner, at the exact location thereof, a permanent marker was placed consisting of a cast iron monument with a sign and post on the north side

AND on the 9th day of September, 2011, said permanent marker was found and the ties were updated. Sign was replaced on March 30, 2012.

Updated reference ties are as shown below.

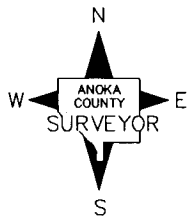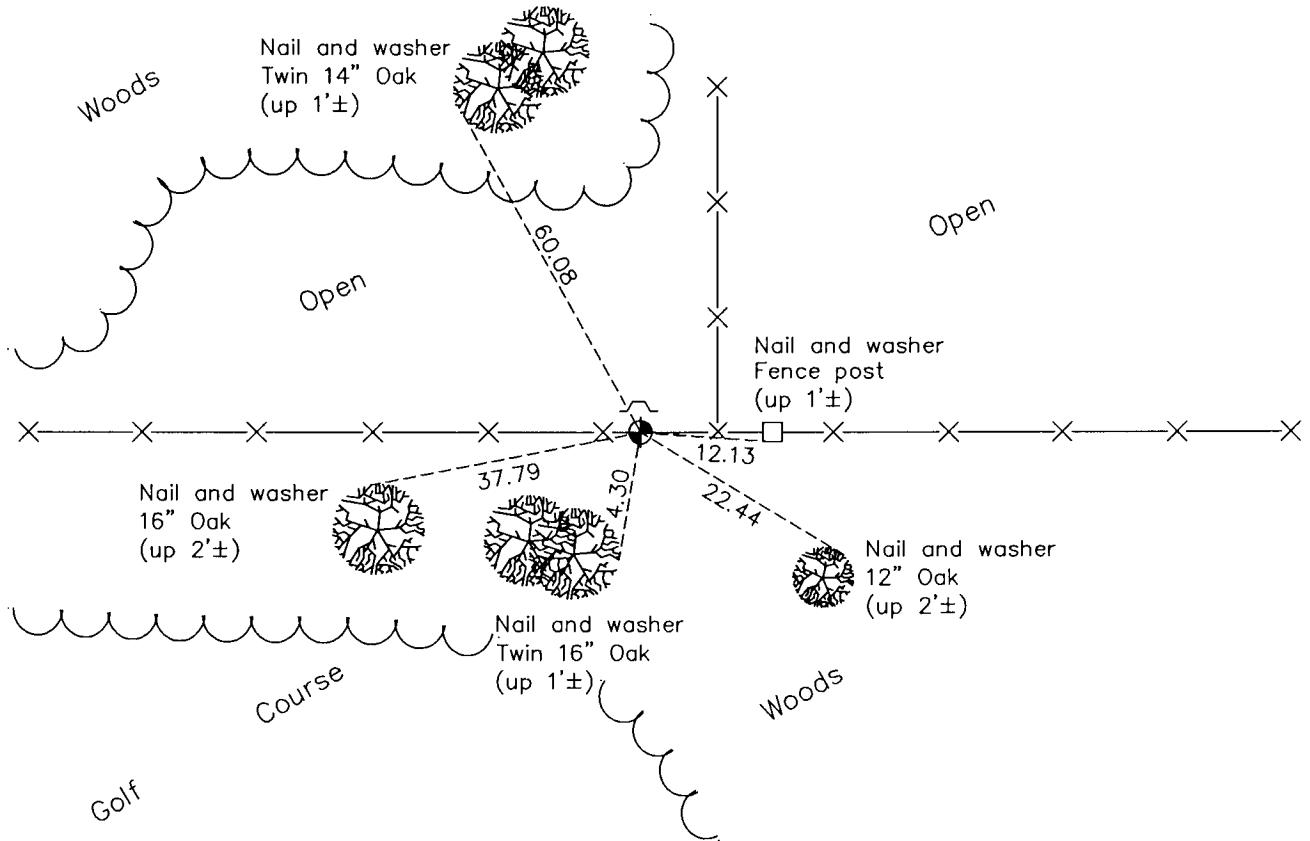

Revision Date

6/05/12

N.A.D. 1983 Coordinates
(1996 Adjustment)

County Project Coordinates	
Northing	224838.9643
Easting	484490.3176
Date	4/24/01

I hereby certify that this United States public land survey monument record is correct and complete to the best of my knowledge and belief.

Larry D. Hoium Date 6/05/12

Larry D. Hoium, Anoka County Surveyor
Minnesota License Number 18165