

CERTIFICATE OF LOCATION OF GOVERNMENT CORNER

County of Anoka

State of Minnesota



Northwest Corner of Sec. 10 Township 33 Range 24

On the 26th day of November, 1963, the described corner was evidenced by a concrete monument

and to perpetuate the location of said corner, at the exact location thereof, a permanent marker was placed consisting of a cast iron monument

AND on the 7th day of September, 2011, said permanent marker was found and the ties were updated

Updated reference ties are as shown below.

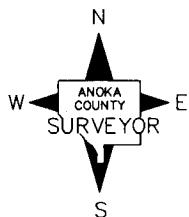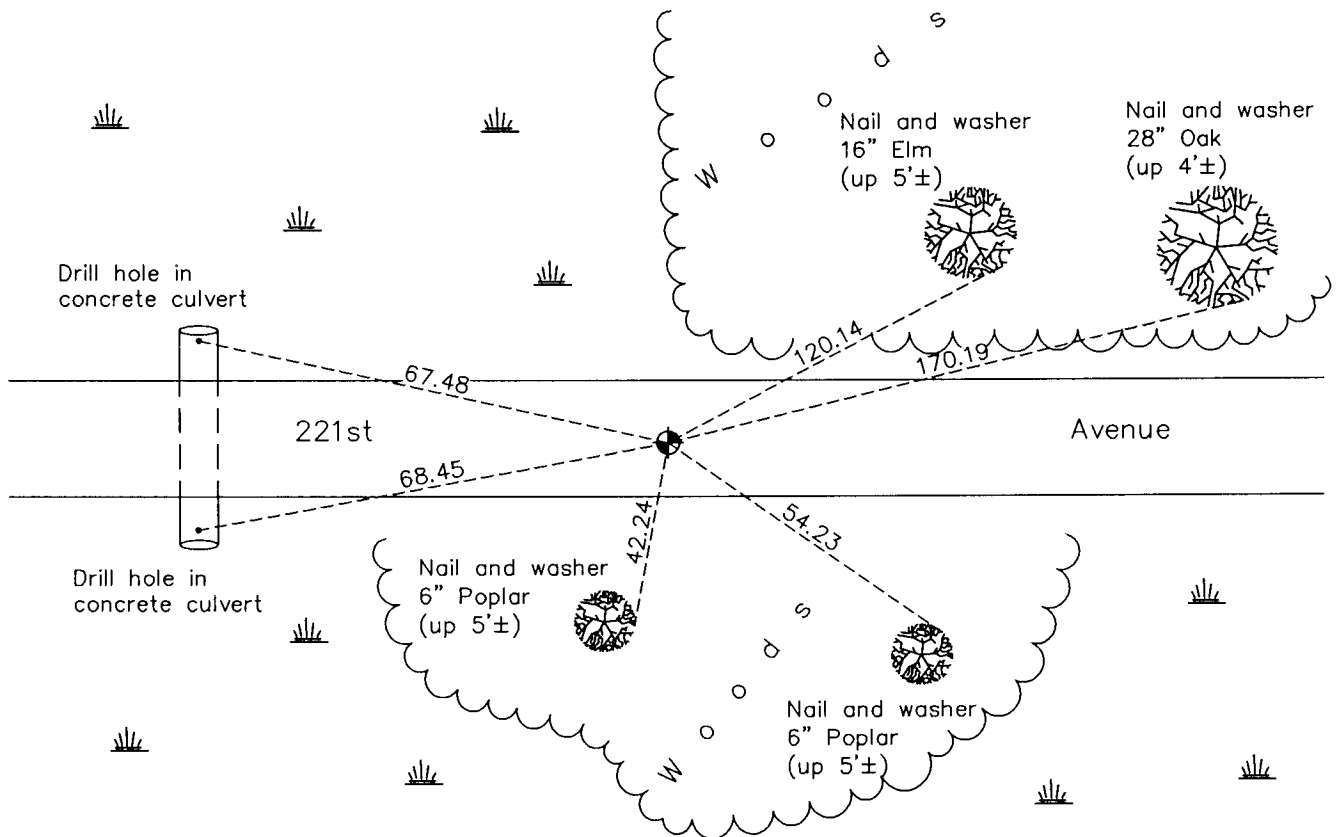

Revision Date

12/07/11

N.A.D. 1983 Coordinates
(1996 Adjustment)

County Project Coordinates

Northing 222187.1804

Easting 484445.1917

Date 2/22/01

I hereby certify that this United States public land survey monument record is correct and complete to the best of my knowledge and belief.

Larry D. Hoium Date 12/07/11

Larry D. Hoium, Anoka County Surveyor

Minnesota License Number 18165