

CERTIFICATE OF LOCATION OF GOVERNMENT CORNER

County of Anoka

State of Minnesota



Witness Corner of Sec. 11 Township 33 Range 24
(on south line of section)

On the 14th day of March, 1973, the described corner was evidenced by area resurvey

and to perpetuate the location of said corner, at the exact location thereof, a permanent marker was placed consisting of a cast iron monument

AND on the 20th day of September, 2011, said permanent marker was found and the ties
were updated

Updated reference ties are as shown below.

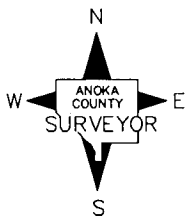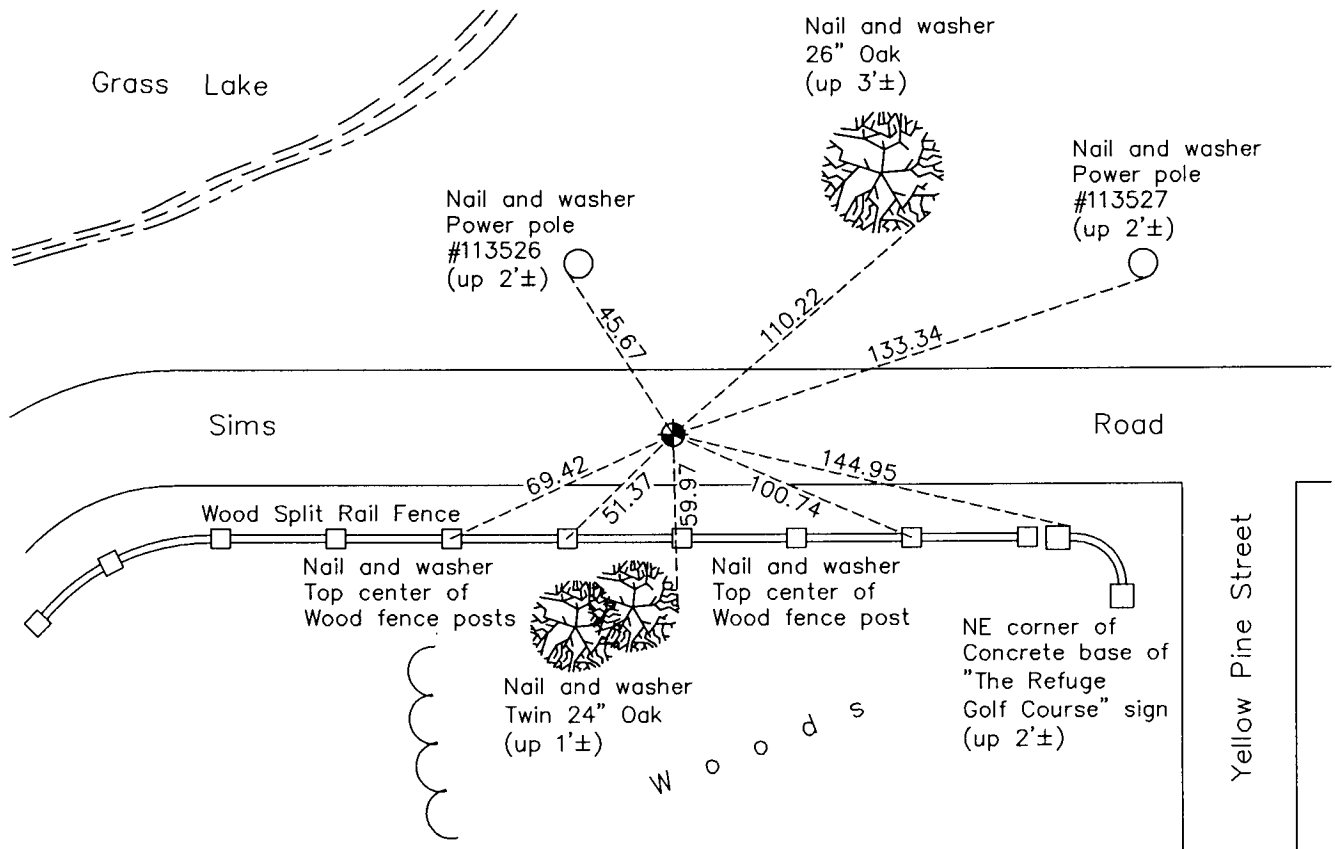

Revision Date
12/13/11

N.A.D. 1983 Coordinates
(1996 Adjustment)

County Project Coordinates	
Northing	216904.2272
Easting	491502.6672
Date	3/26/01

I hereby certify that this United States public land survey monument record is correct and complete to the best of my knowledge and belief.

Larry D. Hoium Date 12/13/11

Larry D. Hoium, Anoka County Surveyor
Minnesota License Number 18165