

CERTIFICATE OF LOCATION OF GOVERNMENT CORNER

County of Anoka

State of Minnesota



Witness Corner of Sec. 17 Township 33 Range 24
 (on north line of section)

On the 16th day of September, 1964, the described corner was evidenced by a 1 1/2" iron pipe

and to perpetuate the location of said corner, at the exact location thereof, a permanent marker was placed consisting of a cast iron monument

AND on the 2nd day of December, 2011, said permanent marker was found and the ties were updated

Updated reference ties are as shown below.

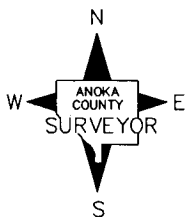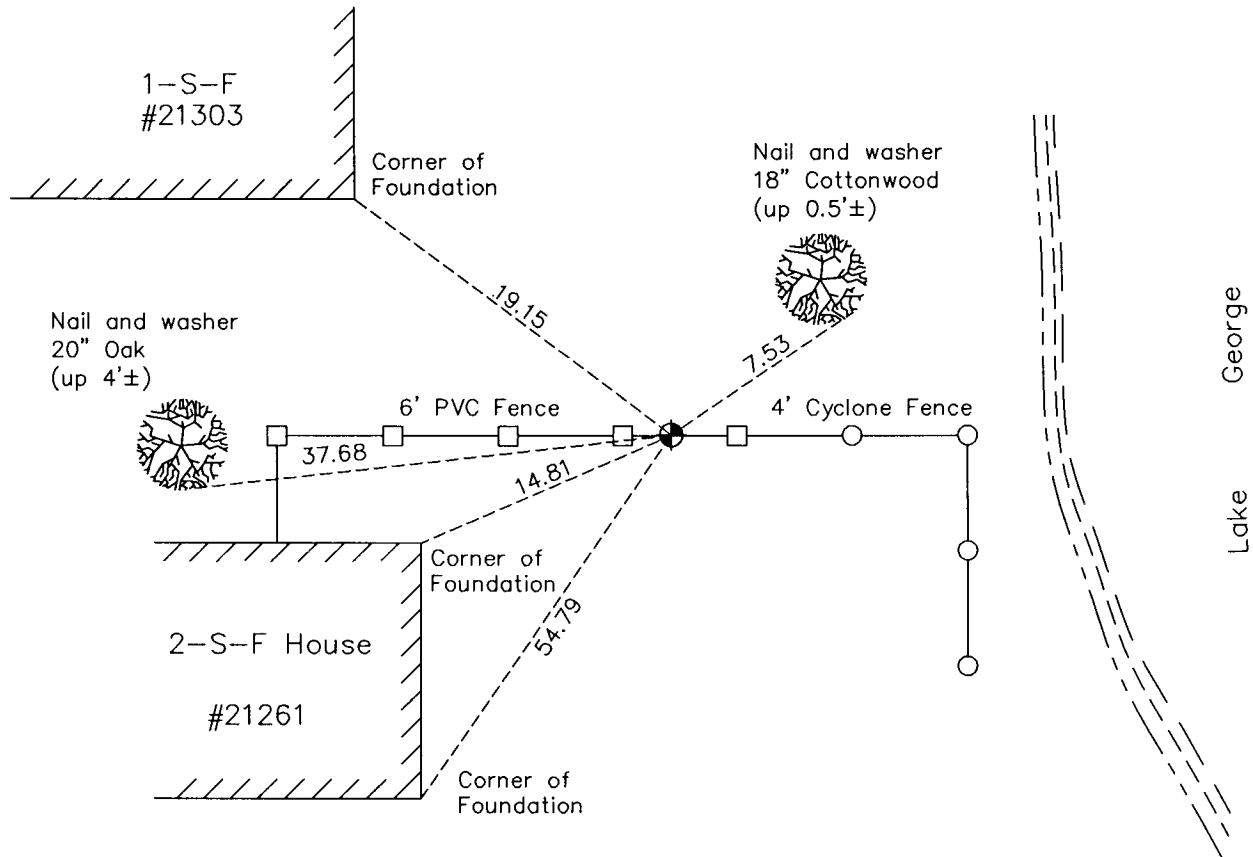

Revision Date
 6/11/12

N.A.D. 1983 Coordinates
 (1996 Adjustment)

County Project Coordinates	
Northing	216996.4493
Easting	479050.6193
Date	5/10/01

I hereby certify that this United States public land survey monument record is correct and complete to the best of my knowledge and belief.
Larry D. Hoium Date 6/11/12
 Larry D. Hoium, Anoka County Surveyor
 Minnesota License Number 18165