

CERTIFICATE OF LOCATION OF GOVERNMENT CORNER

County of Anoka

State of Minnesota



West 1/4 Corner of Sec. 18 Township 33 Range 24

On the 11th day of February, 1966, the described corner was evidenced by a 1/2" iron pipe set by Cartwright

and to perpetuate the location of said corner, at the exact location thereof, a permanent marker was placed consisting of the same 1/2" iron pipe

AND on the 26th day of January, 2012, said permanent marker was found down 0.5'± and the ties were updated. Iron pipe has pinched end and has a MNDOT sign & post on the east side.

Updated reference ties are as shown below.

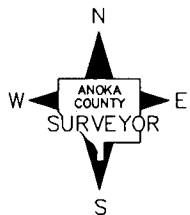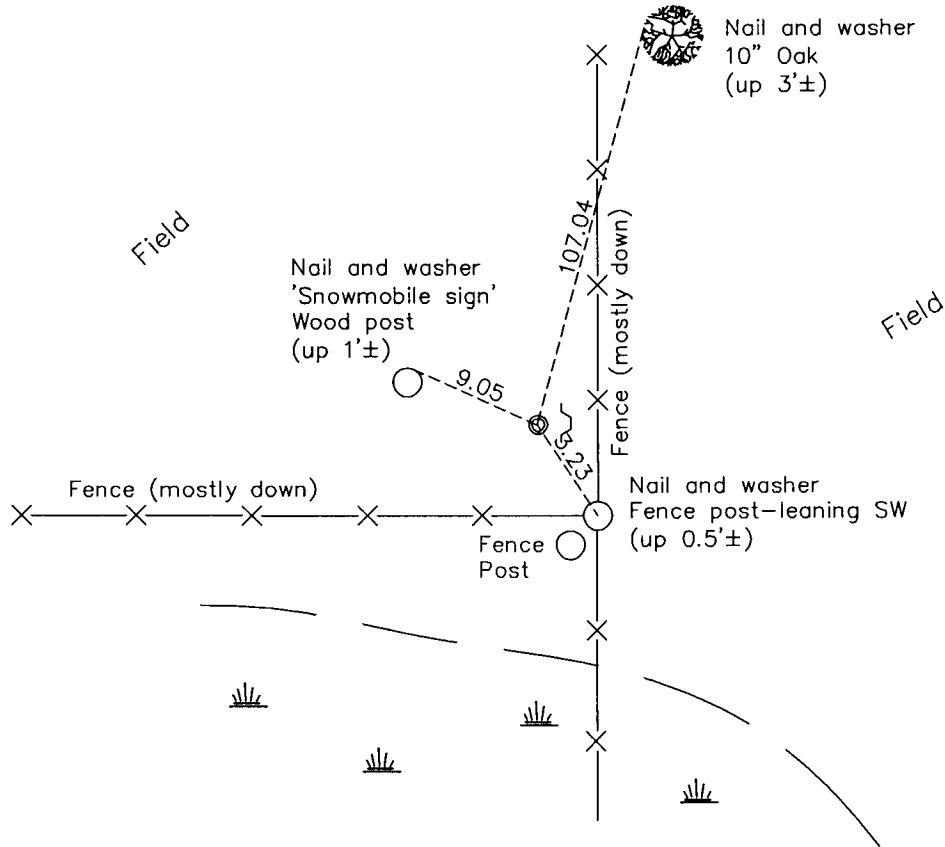

N.A.D. 1983 Coordinates
(1996 Adjustment)

| County Project Coordinates | |
|----------------------------|--------------------|
| Northing | <u>214541.4154</u> |
| Easting | <u>468657.3642</u> |
| Date | <u>6/29/01</u> |

Revision Date
6/12/12

I hereby certify that this United States public land survey monument record is correct and complete to the best of my knowledge and belief.

Larry D. Hoium Date 6/12/12

Larry D. Hoium, Anoka County Surveyor

Minnesota License Number 18165