

CERTIFICATE OF LOCATION OF GOVERNMENT CORNER

County of Anoka

State of Minnesota



East 1/4 Corner of Sec. 16 Township 33 Range 24

On the 29th day of October, 1965, the described corner was evidenced by area resurvey

and to perpetuate the location of said corner, at the exact location thereof, a permanent marker was placed consisting of a cast iron monument

AND on the 10th day of November, 2011, said permanent marker was found and the ties were updated. On April 6, 2012 a sign and post was set on the east side.

Updated reference ties are as shown below.

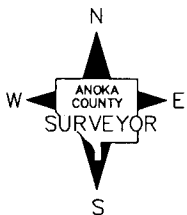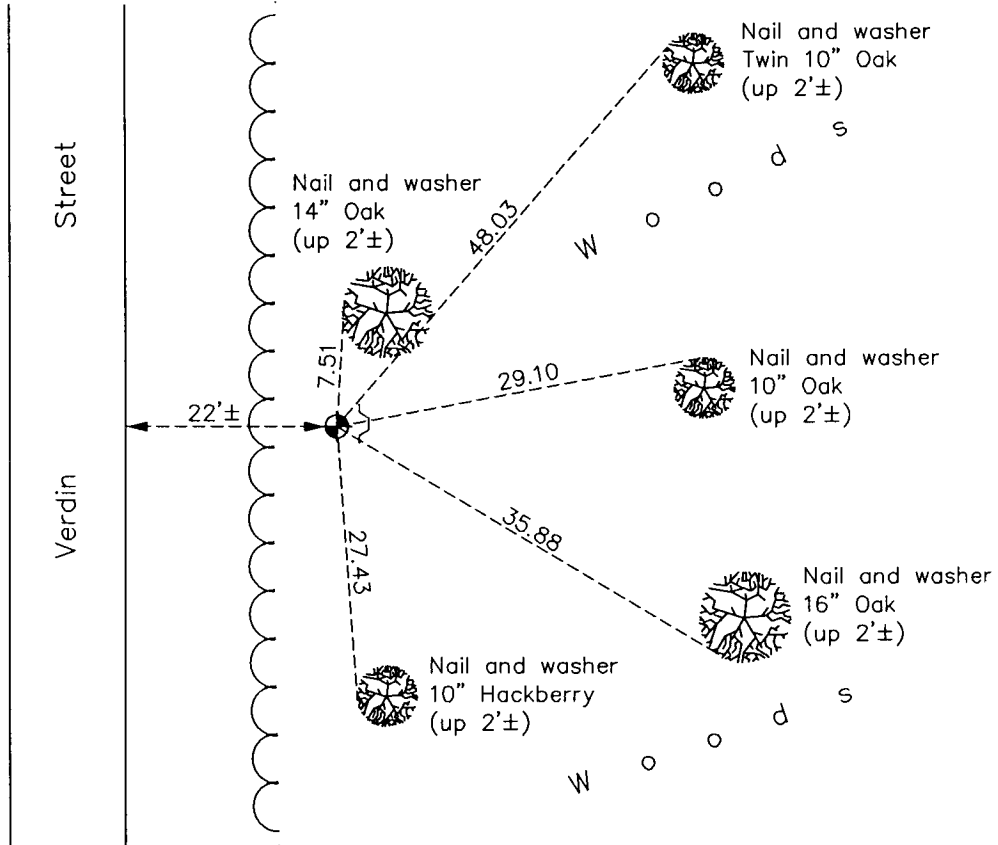

Revision Date
6/13/12

N.A.D. 1983 Coordinates
(1996 Adjustment)

County Project Coordinates	
Northing	214230.9194
Easting	484442.6795
Date	5/15/01

I hereby certify that this United States public land survey monument record is correct and complete to the best of my knowledge and belief.

Larry D. Hoium Date 6/13/12

Larry D. Hoium, Anoka County Surveyor

Minnesota License Number 18165