

CERTIFICATE OF LOCATION OF GOVERNMENT CORNER

County of Anoka

State of Minnesota



East $\frac{1}{4}$ Corner of Sec. 15 Township 33 Range 24

On the 19th day of March, 1973, the described corner was evidenced by area resurvey

and to perpetuate the location of said corner, at the exact location thereof, a permanent marker was placed consisting of a red and white iron pipe

AND on the 2nd day of December, 2011, said permanent marker was found with a broken sign attached and a 6.5' pipe to NE. On April 6, 2012 sign was replaced and ties were updated.

Updated reference ties are as shown below.

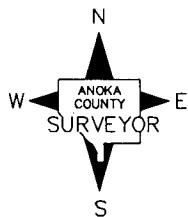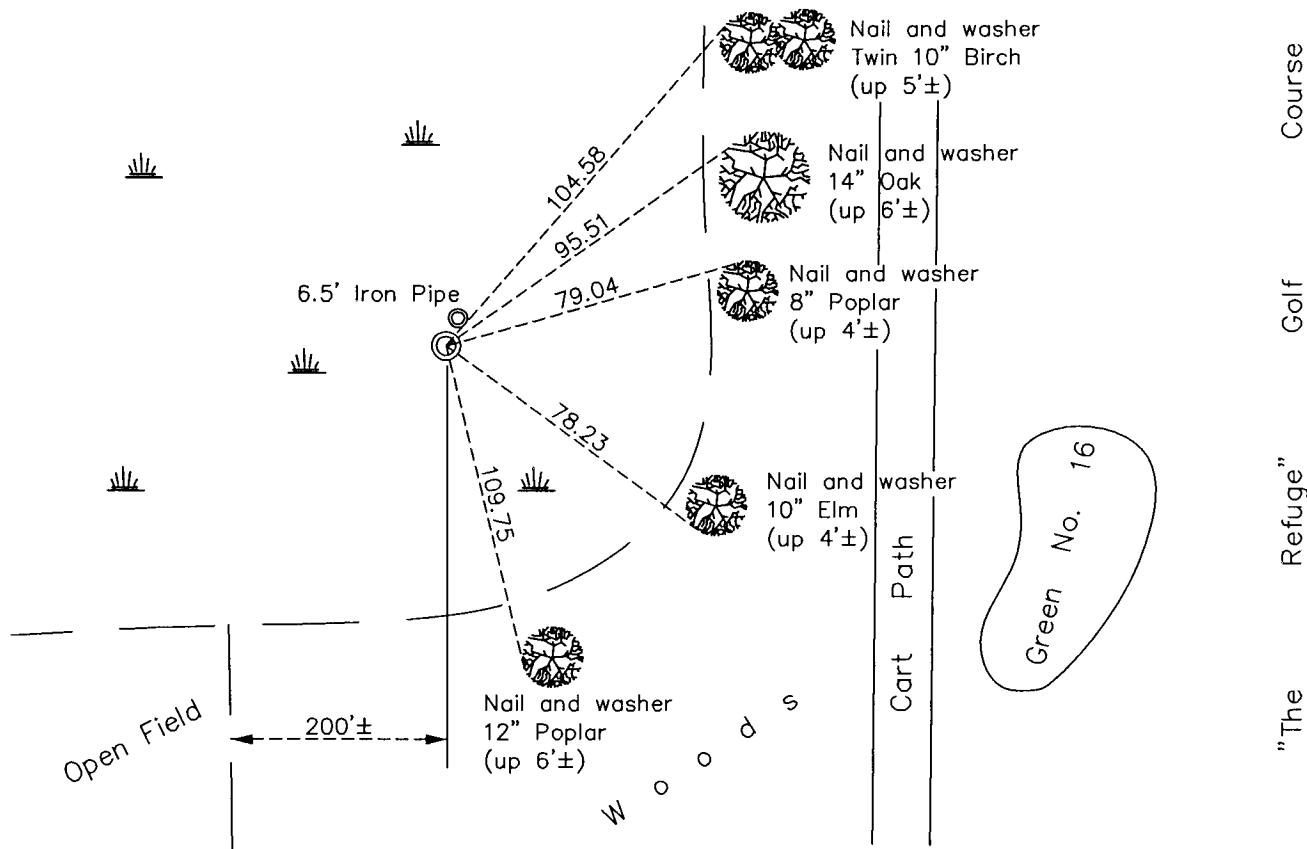

Revision Date
6/13/12

N.A.D. 1983 Coordinates
(1996 Adjustment)

County Project Coordinates	
Northing	<u>214254.5882</u>
Easting	<u>489691.5998</u>
Date	<u>2/20/02</u>

I hereby certify that this United States public land survey monument record is correct and complete to the best of my knowledge and belief.

Larry D. Hoium Date 6/13/12

Larry D. Hoium, Anoka County Surveyor

Minnesota License Number 18165