

CERTIFICATE OF LOCATION OF GOVERNMENT CORNER

County of Anoka

State of Minnesota



Northeast Corner of Sec. 24 Township 33 Range 24

On the 5th day of May, 1972, the described corner was evidenced by area resurvey

and to perpetuate the location of said corner, at the exact location thereof, a permanent marker was placed consisting of a cast iron monument with a sign and post on the north side

AND on the 14th day of September, 2011, said permanent marker was found and the ties
were updated

Updated reference ties are as shown below.

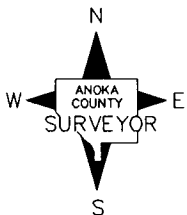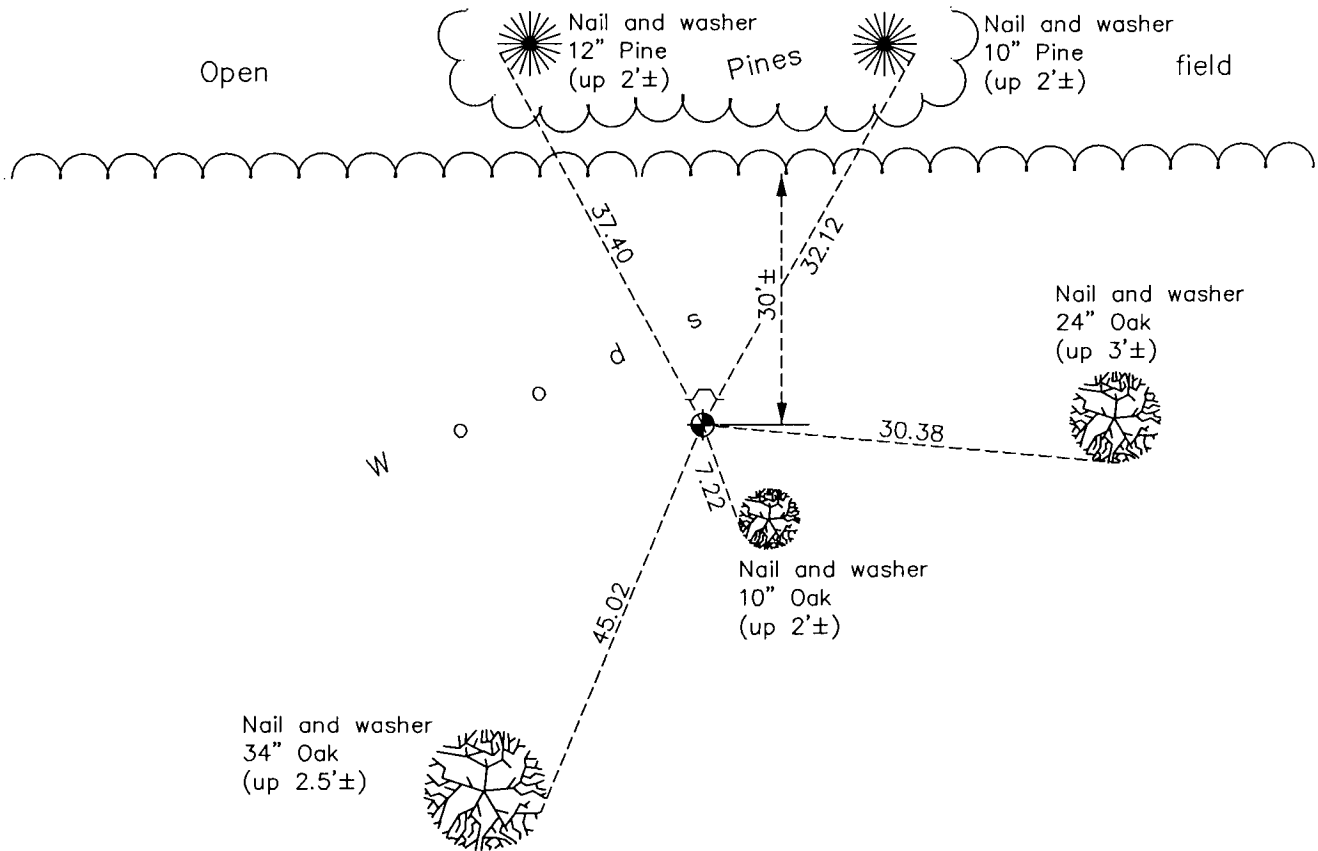

N.A.D. 1983 Coordinates
(1996 Adjustment)

County Project Coordinates	
Northing	<u>211702.2548</u>
Easting	<u>500244.9977</u>
Date	<u>6/07/01</u>

Revision Date
12/14/11

I hereby certify that this United States public land survey monument record is correct and complete to the best of my knowledge and belief.

Larry D. Hoium Date 12/14/11
 Larry D. Hoium, Anoka County Surveyor
 Minnesota License Number 18165