

CERTIFICATE OF LOCATION OF GOVERNMENT CORNER

County of Anoka

State of Minnesota



Northeast Corner of Sec. 20 Township 33 Range 24

On the 15th day of September, 1964, the described corner was evidenced by a 1/2" iron pipe

and to perpetuate the location of said corner, at the exact location thereof, a permanent marker was placed consisting of a cast iron monument on centerline

AND on the 27th day of March, 2012, said permanent marker was found and the ties were updated

Updated reference ties are as shown below.

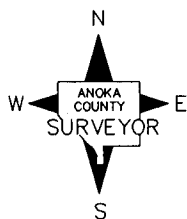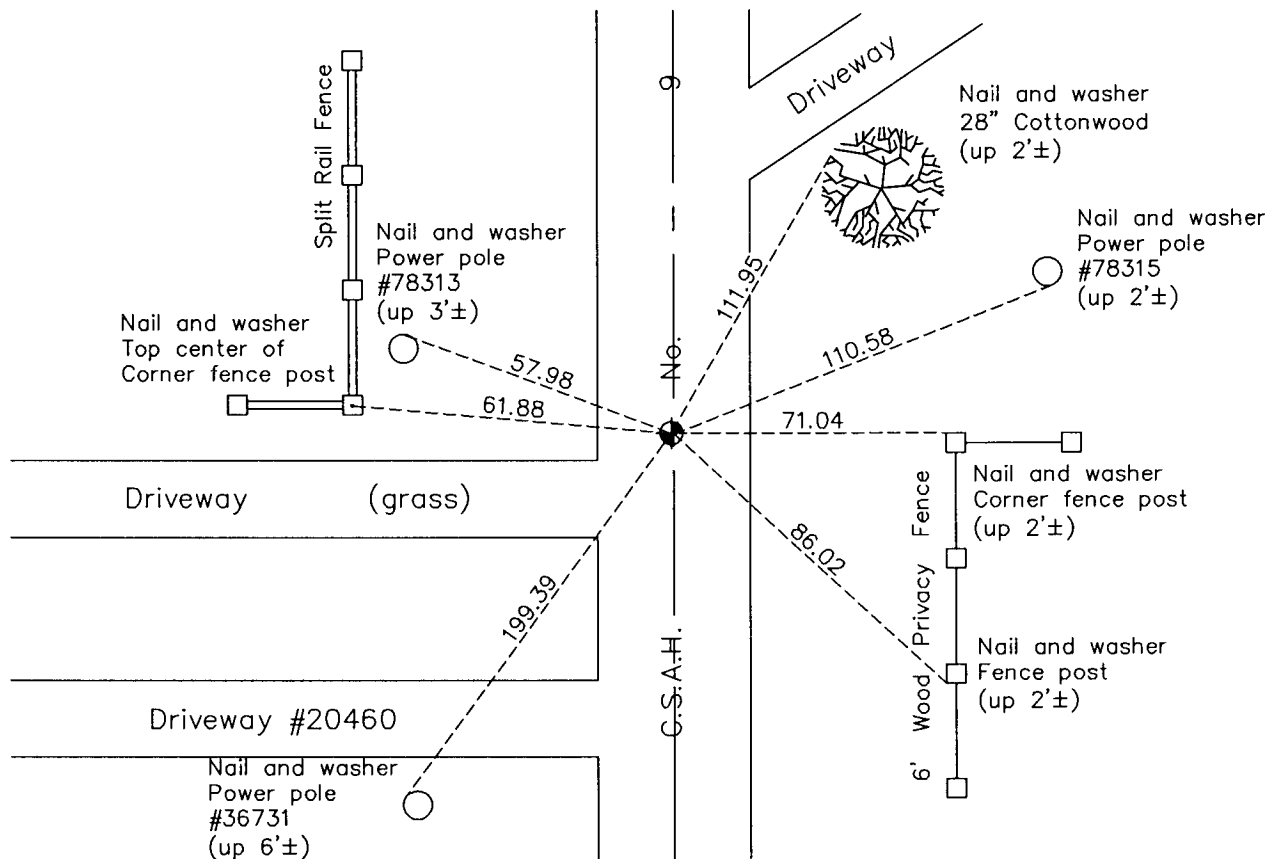

Revision Date
6/13/12

N.A.D. 1983 Coordinates
(1996 Adjustment)

County Project Coordinates	
Northing	211714.1097
Easting	479239.6502
Date	6/08/01

I hereby certify that this United States public land survey monument record is correct and complete to the best of my knowledge and belief.

Larry D. Hoium Date 6/13/12
 Larry D. Hoium, Anoka County Surveyor
 Minnesota License Number 18165