

# CERTIFICATE OF LOCATION OF GOVERNMENT CORNER

County of Anoka

State of Minnesota



## East 1/4 Corner of Sec. 19 Township 33 Range 24

On the 2nd day of December, 1963, the described corner was evidenced by a 4" square concrete monument

and to perpetuate the location of said corner, at the exact location thereof, a permanent marker was placed consisting of the same concrete monument with a sign and post on the NW side

AND on the 9th day of February, 2012, said permanent marker was found up 0.2'± and the ties were updated. On April 5, 2012 the sign and post was moved to the south side.

Updated reference ties are as shown below.

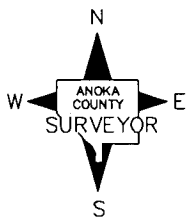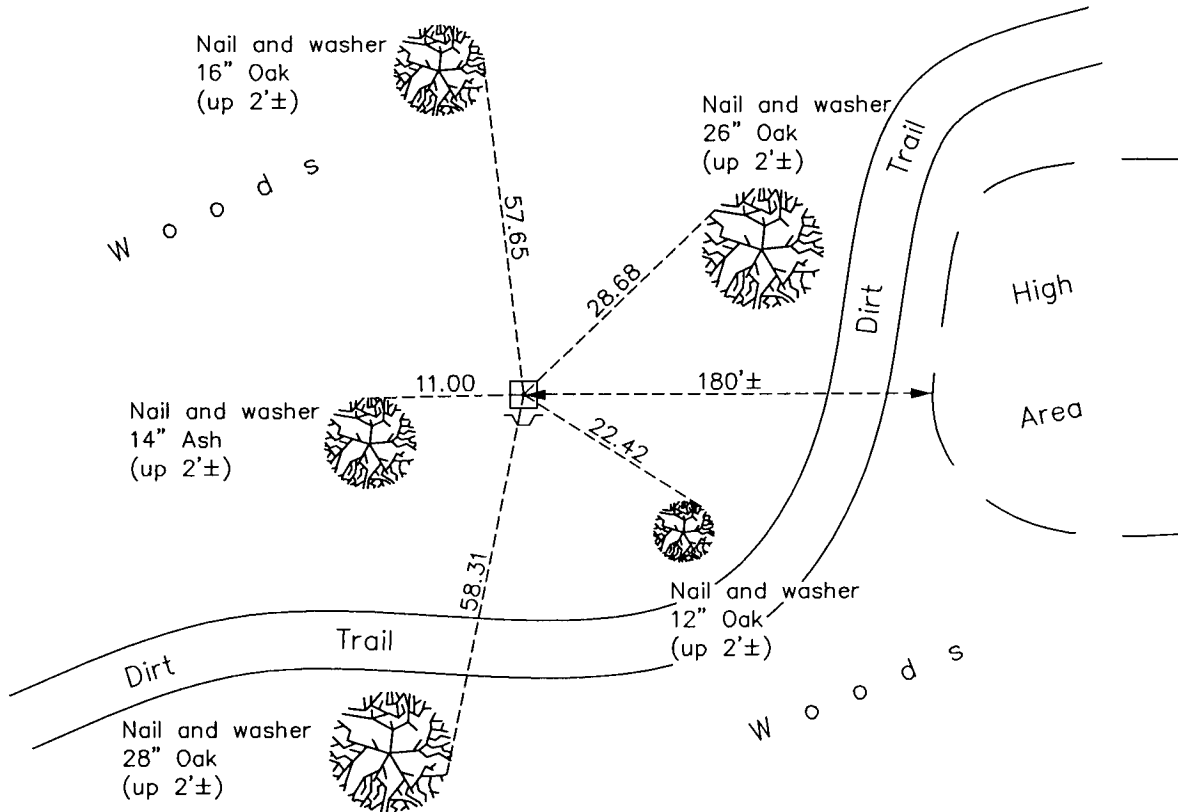

Revision Date  
6/14/12

N.A.D. 1983 Coordinates  
(1996 Adjustment)

| County Project Coordinates |                    |
|----------------------------|--------------------|
| Northing                   | <u>209263.7188</u> |
| Easting                    | <u>473946.6120</u> |
| Date                       | <u>3/19/02</u>     |

I hereby certify that this United States public land survey monument record is correct and complete to the best of my knowledge and belief.

*Larry D. Hoium* Date 6/14/12

\_\_\_\_\_  
Larry D. Hoium, Anoka County Surveyor

Minnesota License Number 18165