

# CERTIFICATE OF LOCATION OF GOVERNMENT CORNER

County of Anoka

State of Minnesota


North 1/4 Corner of Sec. 25 Township 33 Range 24

On the 30th day of August, 1971, the described corner was evidenced by area resurvey

and to perpetuate the location of said corner, at the exact location thereof, a permanent marker was placed consisting of a cast iron monument

AND on the \_\_\_ day of \_\_\_\_\_, \_\_\_\_\_, said permanent marker was \_\_\_\_\_

Updated reference ties are as shown below.

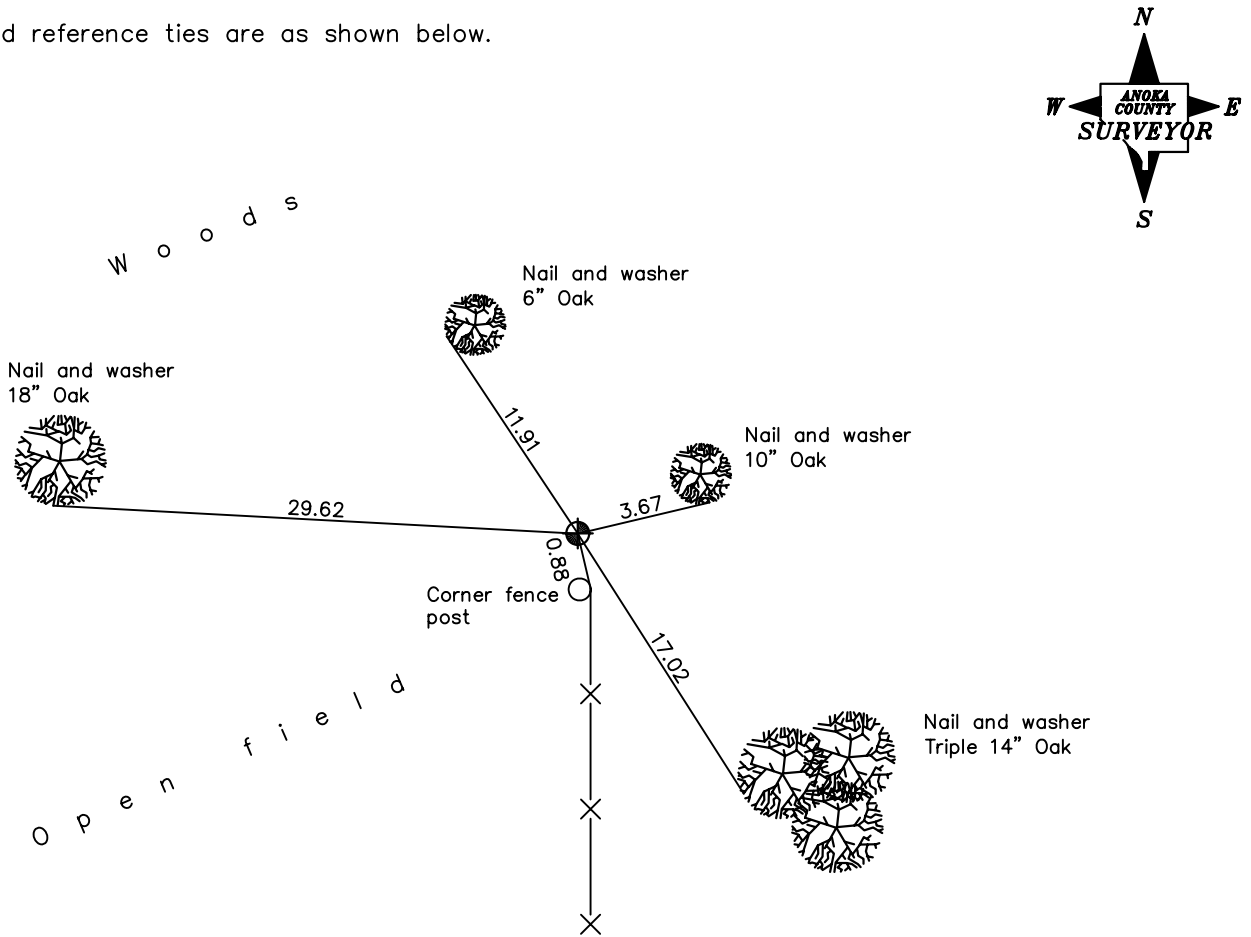

Revised date

|         |
|---------|
| 7/15/92 |
| 7/09/97 |
|         |
|         |
|         |

N.A.D. 1983 Coordinates  
(1996 Adjustment)

|                             |
|-----------------------------|
| County Project Coordinates  |
| Northing <u>206409.4482</u> |
| Easting <u>497608.6500</u>  |
| Date <u>7/03/01</u>         |

I hereby certify that this United States public land survey monument record is correct and complete to the best of my knowledge and belief.

\_\_\_\_\_ Date \_\_\_\_\_  
 \_\_\_\_\_, Anoka County Surveyor  
 Minnesota License Number \_\_\_\_\_