

# CERTIFICATE OF LOCATION OF GOVERNMENT CORNER

County of Anoka

State of Minnesota



## East 1/16 Corner of Sec. 21 Township 33 Range 24 (on east line of SE1/4)

On the 24th day of April, 1973, the described corner was evidenced by area resurvey

and to perpetuate the location of said corner, at the exact location thereof, a permanent marker was placed consisting of a cast iron monument with a sign and post on the south side

AND on the 1st day of February, 2012, said permanent marker was found and the ties were updated

Updated reference ties are as shown below.

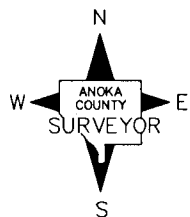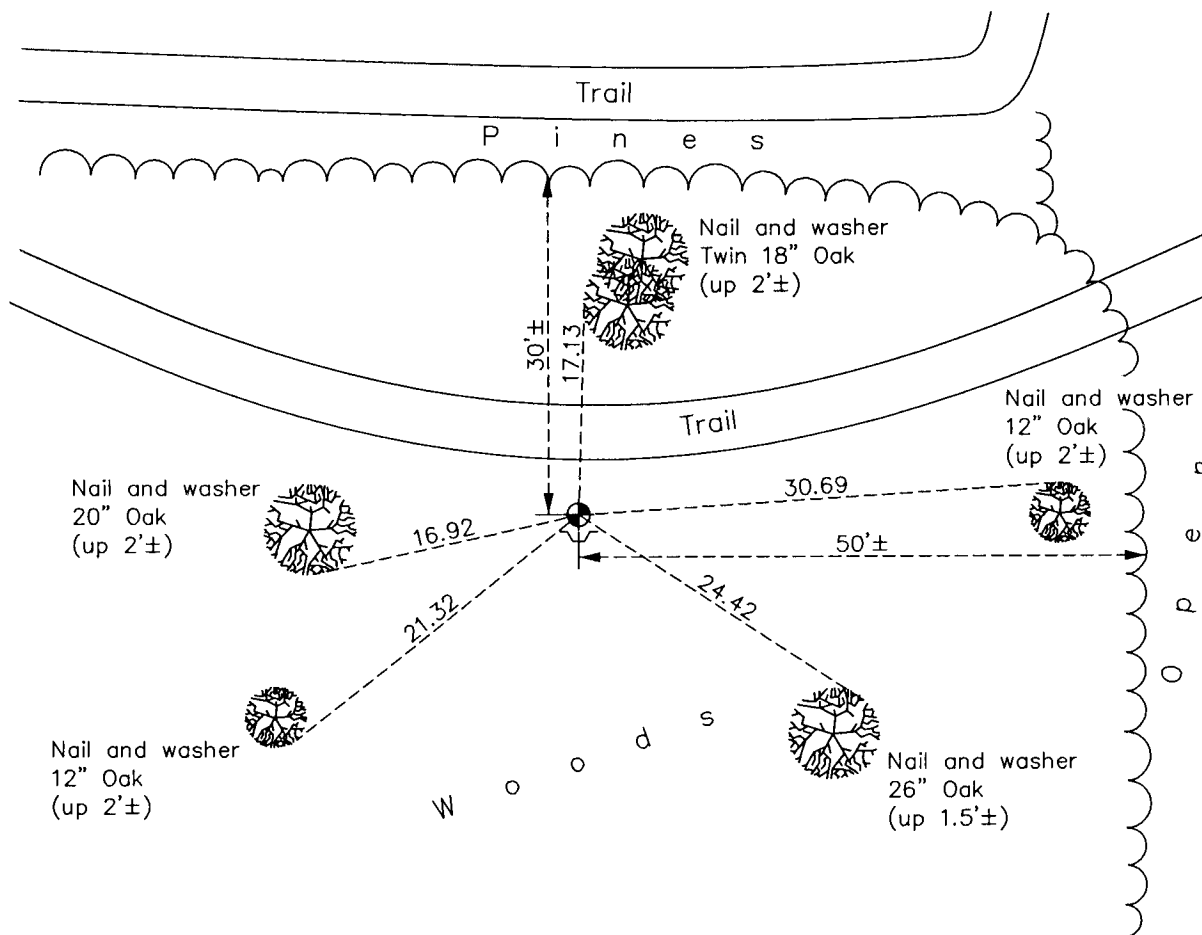

N.A.D. 1983 Coordinates  
(1996 Adjustment)

County Project Coordinates

Northing 207709.2353

Easting 484500.4897

Date 2/21/02

Revision Date

9/17/12

I hereby certify that this United States public land survey monument record is correct and complete to the best of my knowledge and belief.

*Larry D. Hoium* Date 9/17/12

Larry D. Hoium, Anoka County Surveyor

Minnesota License Number 18165