

CERTIFICATE OF LOCATION OF GOVERNMENT CORNER

County of Anoka

State of Minnesota



South 1/4 Corner of Sec. 21 Township 33 Range 24

On the 4th day of April, 1973, the described corner was evidenced by a sandstone monument

and to perpetuate the location of said corner, at the exact location thereof, a permanent marker was placed consisting of a cast iron monument with a sign and post on the south side

AND on the 13th day of February, 2012, said permanent marker was found and the ties were updated

Updated reference ties are as shown below.

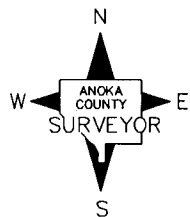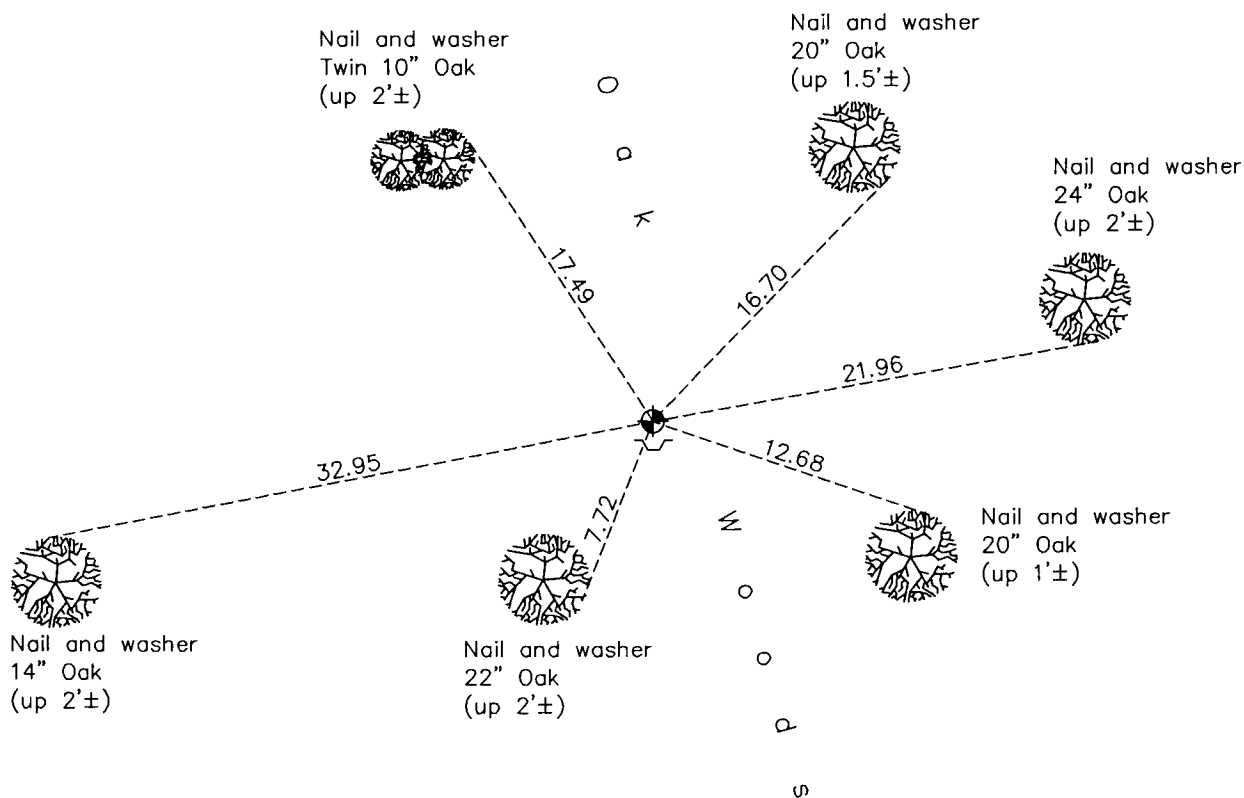

N.A.D. 1983 Coordinates
(1996 Adjustment)

County Project Coordinates	
Northing	<u>206437.5915</u>
Easting	<u>481932.7765</u>
Date	<u>2/21/02</u>

Revision Date
9/18/12

I hereby certify that this United States public land survey monument record is correct and complete to the best of my knowledge and belief.

Larry D. Hoium Date 9/18/12

Larry D. Hoium, Anoka County Surveyor

Minnesota License Number 18165