

# CERTIFICATE OF LOCATION OF GOVERNMENT CORNER

County of Anoka

State of Minnesota



West 1/4 Corner of Sec. 31 Township 33 Range 24

On the 13th day of December, 1965, the described corner was evidenced by area resurvey

and to perpetuate the location of said corner, at the exact location thereof, a permanent marker was placed consisting of a cast iron monument with a sign and post on the north side

AND on the 20th day of January, 2012, said permanent marker was found with fallen trees lying over the sign and monument and the ties were updated

Updated reference ties are as shown below.

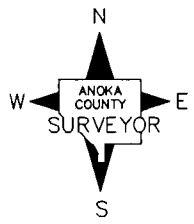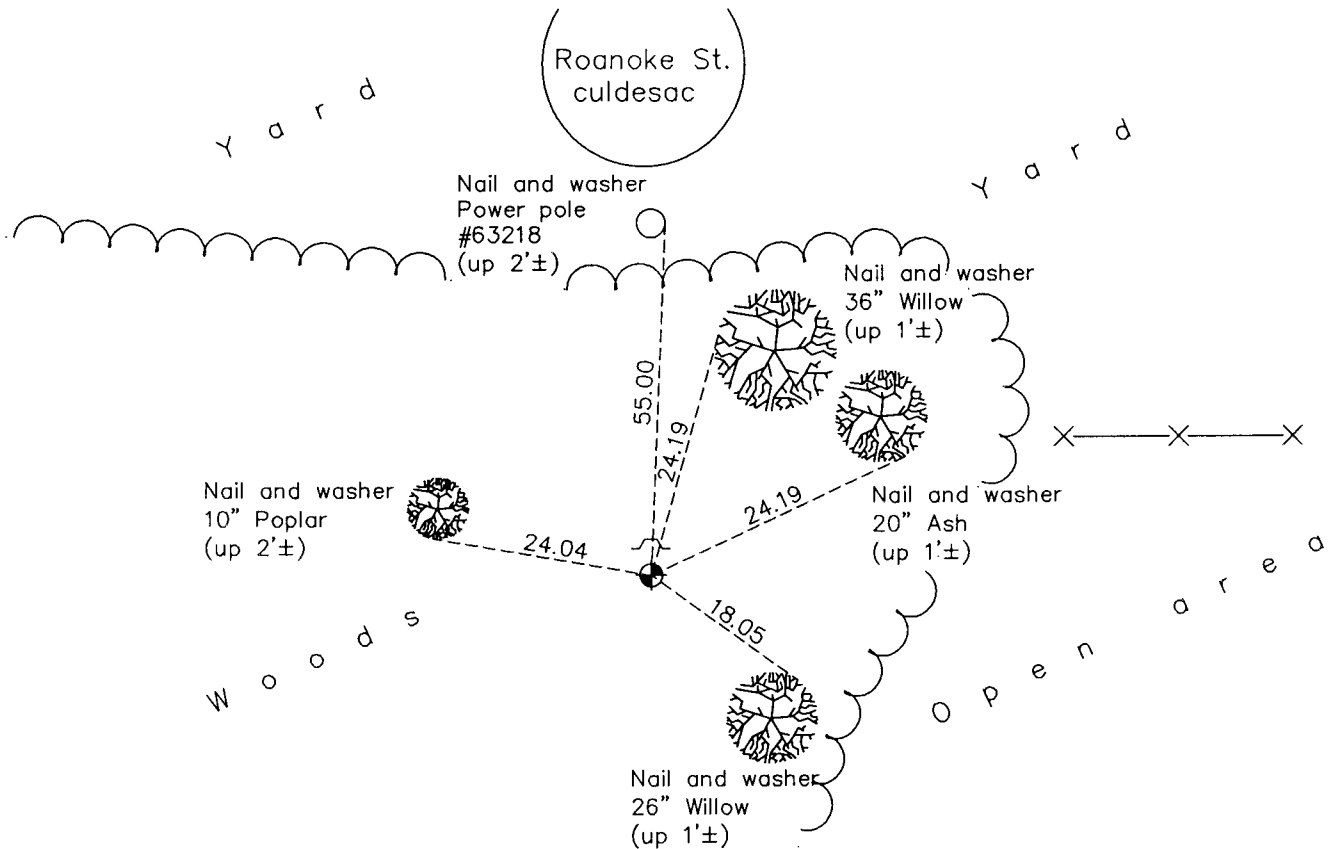

Revision Date  
12/12/12

N.A.D. 1983 Coordinates  
(1996 Adjustment)

County Project Coordinates	
Northing	<u>198769.9087</u>
Easting	<u>468654.6967</u>
Date	<u>11/07/01</u>

I hereby certify that this United States public land survey monument record is correct and complete to the best of my knowledge and belief.

*Larry D. Hoium* Date 12/12/12

Larry D. Hoium, Anoka County Surveyor  
Minnesota License Number 18165