

CERTIFICATE OF LOCATION OF GOVERNMENT CORNER

County of Anoka

State of Minnesota



CENTER Corner of Sec. 1 Township 31 Range 25

I hereby certify that on the 26 day of JUNE, 1963, I found the described corner which was evidenced by 3/4" IRON PIPE

and I further certify that to perpetuate the location of said corner, I did, at the exact location thereof, place a permanent marker consisting of 3/4" IRON PIPE

which reference or witness monuments are located in the manner following:

N.A.D.	1983	Co-ordinates
County	Project	Co-ordinates
Northing	<u>161967.1637</u>	
Easting	<u>465879.7409</u>	
State Plane Co-ordinates		
Y	_____	

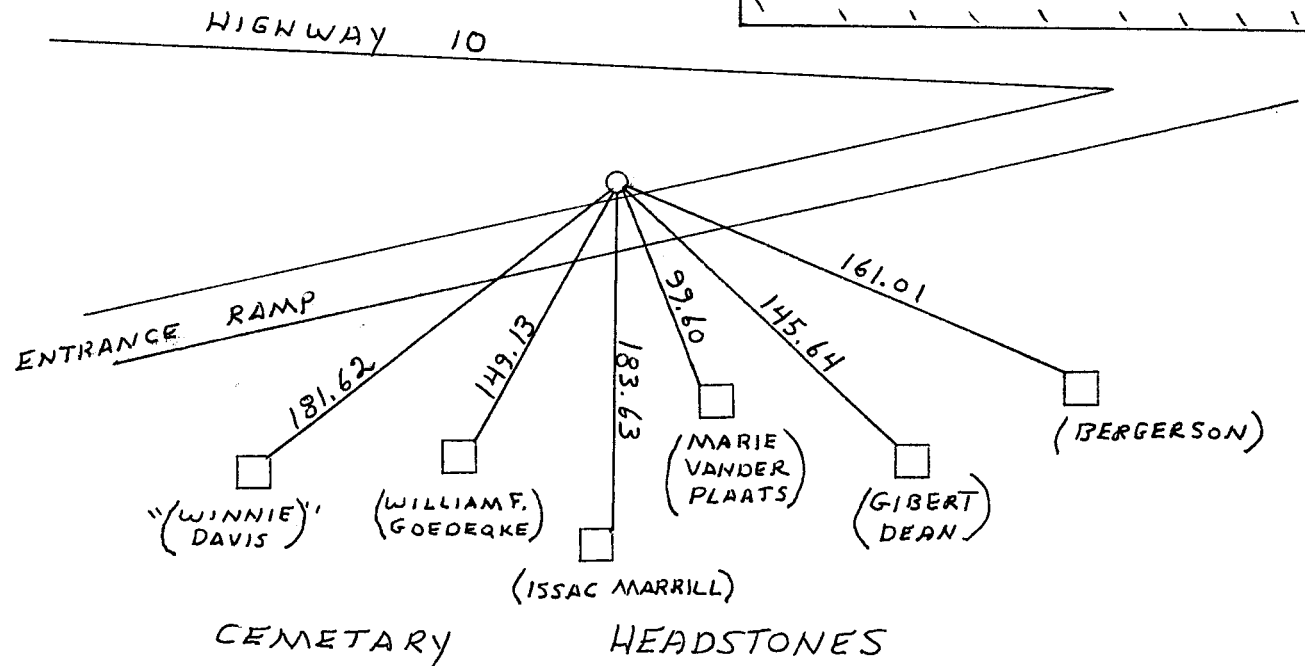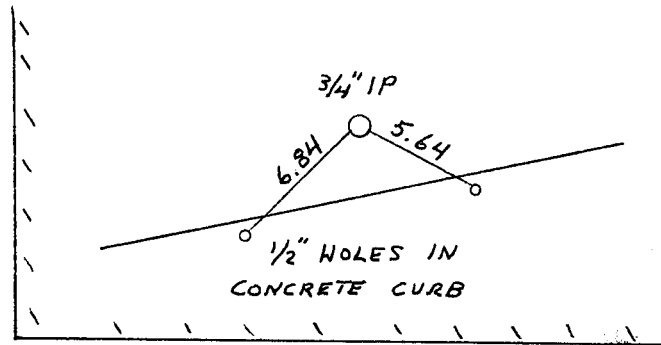

Revised date	By
6-16-86	D. ROSS
1-25-88	H. LARSON

Minnesota State Plane Coordinates
South Zone
Y _____ X _____
_____, _____
County Surveyor Date
Registered Land Surveyor No. _____