

# CERTIFICATE OF LOCATION OF GOVERNMENT CORNER

County of Anoka

State of Minnesota

## North 1/4 Corner of Sec. 19 Township 32 Range 22


On the 20th day of February, 2013, the described corner was evidenced by inplace witness corner monumentation and government survey

and to perpetuate the location of said corner, at the exact location thereof, a permanent marker was placed consisting of a 2" square steel Telspar monument with a 'County Surveyor' cap.


Set sign and post on the south side.

AND on the \_\_\_\_ day of \_\_\_\_\_, \_\_\_\_\_, said permanent marker was \_\_\_\_\_

Updated reference ties are as shown below.

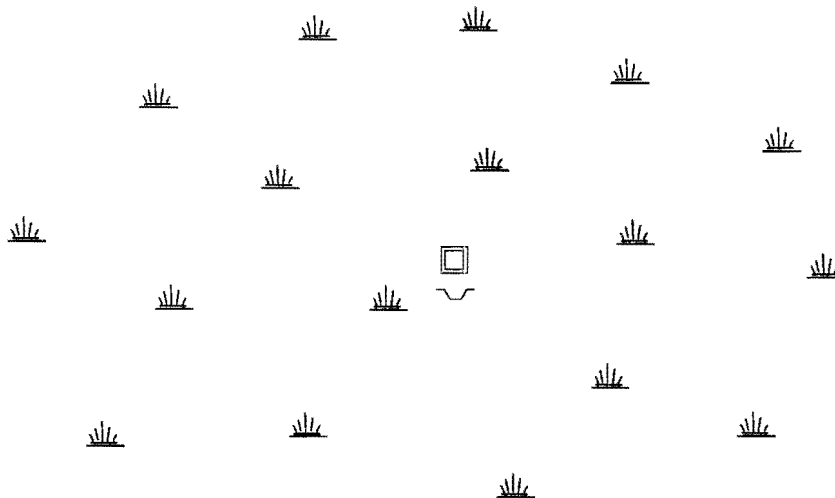

NOTE: There are no physical features available to provide reference ties.

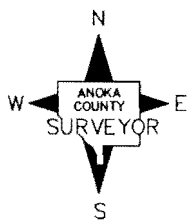

Revision Date

2/26/13

N.A.D. 1983 Coordinates  
(1996 Adjustment)

County Project Coordinates	
Northing	<u>179908.0198</u>
Easting	<u>534731.3532</u>
Date	<u>2/20/13</u>

I hereby certify that this United States public land survey monument record is correct and complete to the best of my knowledge and belief.

*Larry D. Hoium* Date 2/26/13

\_\_\_\_\_  
Larry D. Hoium, Anoka County Surveyor

Minnesota License Number 18165

# HISTORY OF GOVERNMENT CORNER

Page No. 131

County of Anoka

State of Minnesota

North 1/4 Corner of Sec. 19 Township 32 Range 22

## **CORNER HISTORY:**

February 20, 2013 - Unable to find any evidence of an existing corner monument. Set 2" square steel Telspar monument in swamp using inplace area monumentation and government proration. Set corner position using proration based on government survey distances between the Northwest corner and Northeast corner of Section 19 and holding to a line based on two inplace Witness corner monuments on the north line of the NW1/4 of Section 19. There are no physical features available to provide reference ties. Set a sign and post on the south side of monument.