

# CERTIFICATE OF LOCATION OF GOVERNMENT CORNER

County of Anoka

State of Minnesota


## Southeast Corner of Sec. 1 Township 33 Range 23

On the 28th day of March, 1974, the described corner was evidenced by a 1/2" iron pipe

and to perpetuate the location of said corner, at the exact location thereof, a permanent marker was placed consisting of a red and white 2" iron pipe with a sign attached

AND on the 29th day of January, 2013, said permanent marker was found and the ties were updated

Updated reference ties are as shown below.

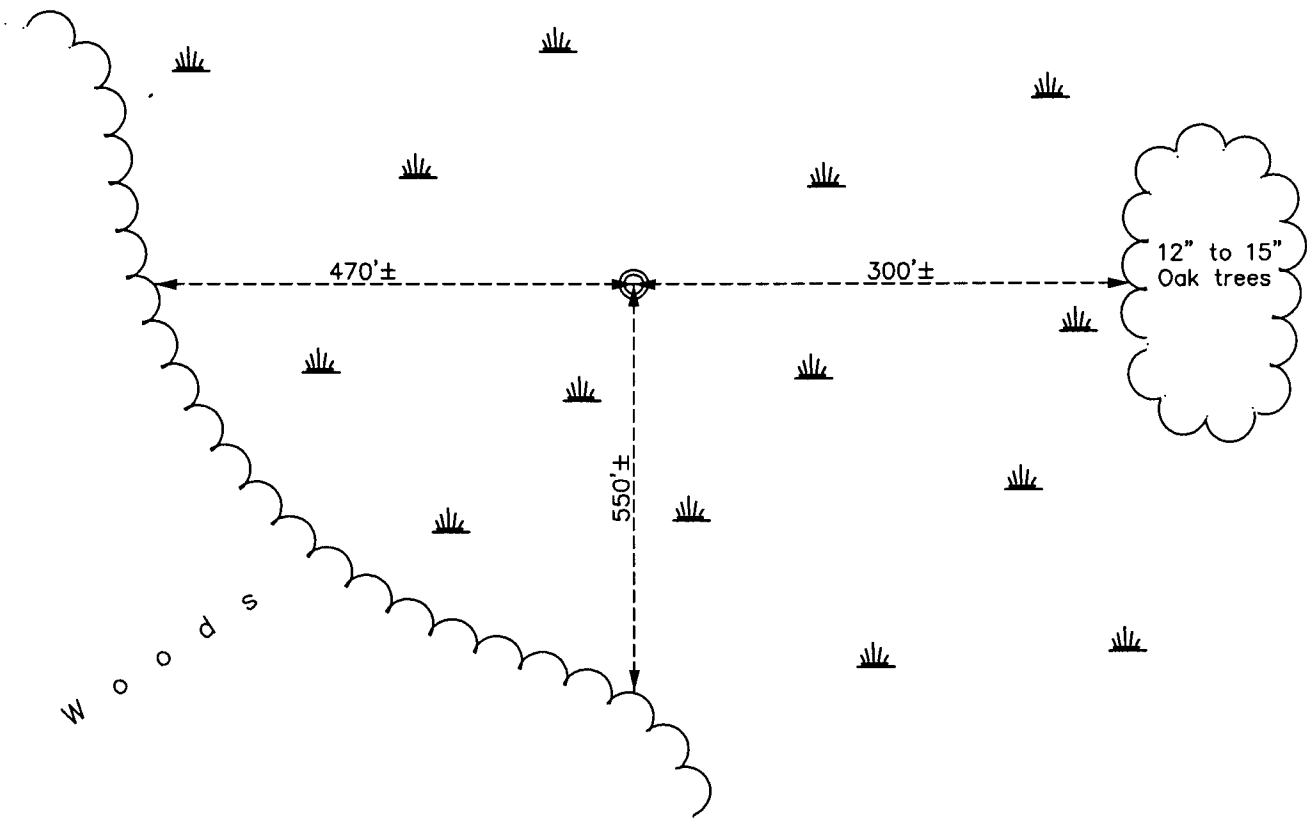

**ANOKA COUNTY SURVEYOR**

Revision Date  
4/17/13

N.A.D. 1983 Coordinates  
(1996 Adjustment)

County Project Coordinates	
Northing	<u>222062.6553</u>
Easting	<u>531529.5903</u>
Date	<u>3/03/03</u>

I hereby certify that this United States public land survey monument record is correct and complete to the best of my knowledge and belief.

*Larry D. Hoium* Date 4/17/13

Larry D. Hoium, Anoka County Surveyor

Minnesota License Number 18165