

CERTIFICATE OF LOCATION OF GOVERNMENT CORNER

County of Anoka

State of Minnesota



Witness Corner of Sec. 16 Township 33 Range 23
 (On south line of section)

On the 3rd day of July, 1973, the described corner was evidenced by area resurvey

and to perpetuate the location of said corner, at the exact location thereof, a permanent marker was placed consisting of a cast iron monument with a sign and post on the north side

AND on the 26th day of March, 2003, said permanent marker was found and the ties
were updated

Updated reference ties are as shown below.

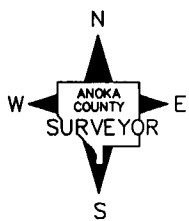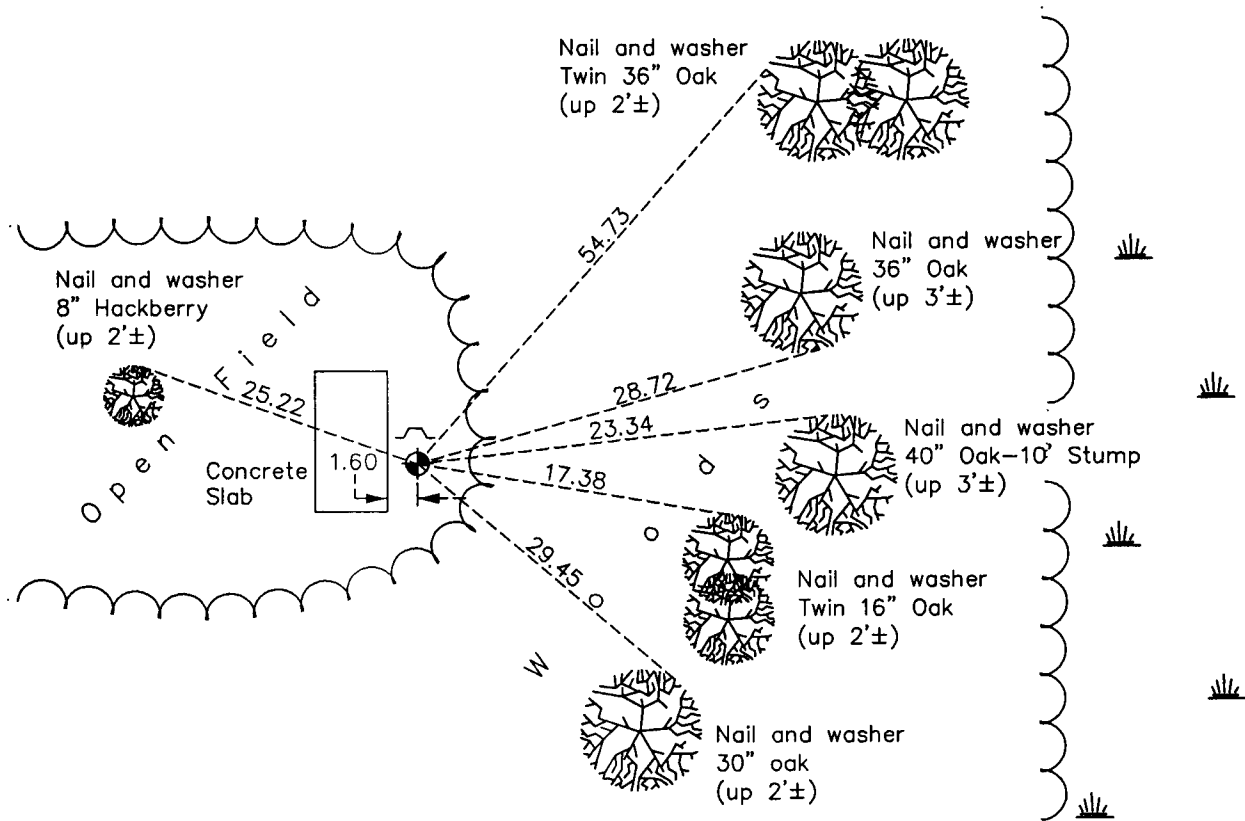

Revision Date
7/18/13

N.A.D. 1983 Coordinates
 (1996 Adjustment)

County Project Coordinates	
Northing	211616.5877
Easting	514888.2822
Date	3/26/03

I hereby certify that this United States public land survey monument record is correct and complete to the best of my knowledge and belief.

Larry D. Hoium Date 7/18/13

 Larry D. Hoium, Anoka County Surveyor

Minnesota License Number 18165