

CERTIFICATE OF LOCATION OF GOVERNMENT CORNER

County of Anoka

State of Minnesota



Southeast Corner of Sec. 17 Township 33 Range 23

On the 17th day of February, 1964, the described corner was evidenced by a concrete monument with a 1 1/2" iron pipe up 3'± on the west side

and to perpetuate the location of said corner, at the exact location thereof, a permanent marker was placed consisting of the same concrete monument with a 1 1/2" iron pipe up 3'± on the west side of monument

AND on the 12th day of February, 2013, said permanent marker was found up 0.5'± and the ties were updated. A County sign and post is on the north side of monument.

Updated reference ties are as shown below.

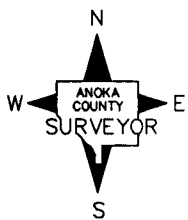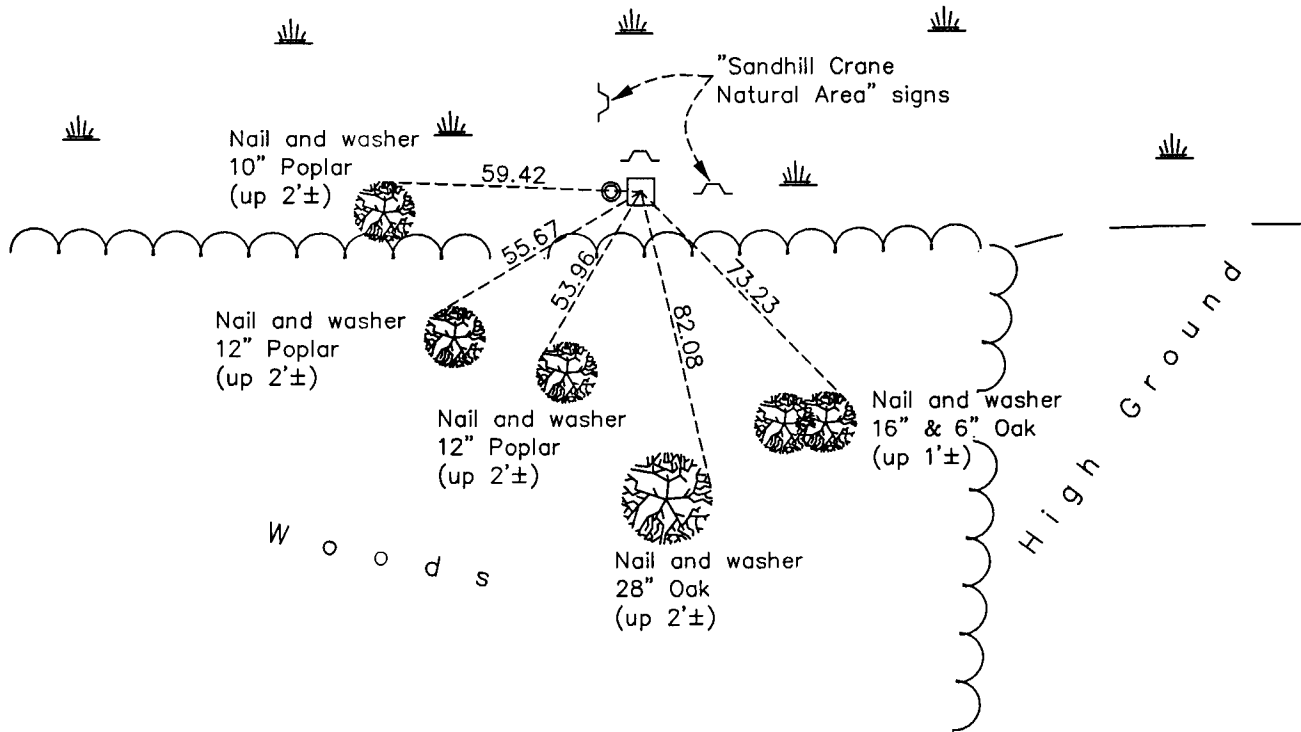

Revision Date
7/22/13

N.A.D. 1983 Coordinates
(1996 Adjustment)

County Project Coordinates	
Northing	211622.0926
Easting	510292.5030
Date	4/23/03

I hereby certify that this United States public land survey monument record is correct and complete to the best of my knowledge and belief.

Larry D. Hoium Date 7/22/13

Larry D. Hoium, Anoka County Surveyor

Minnesota License Number 18165