

CERTIFICATE OF LOCATION OF GOVERNMENT CORNER

County of Anoka

State of Minnesota



East 1/4 Corner of Sec. 20 Township 33 Range 23

On the 7th day of July, 1967, the described corner was evidenced by a concrete monument

and to perpetuate the location of said corner, at the exact location thereof, a permanent marker was placed consisting of a cast iron monument

AND on the 2nd day of August, 2012, said permanent marker was found down 1.5'± and the ties were updated

Updated reference ties are as shown below.

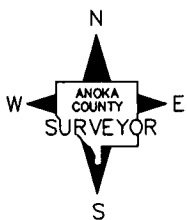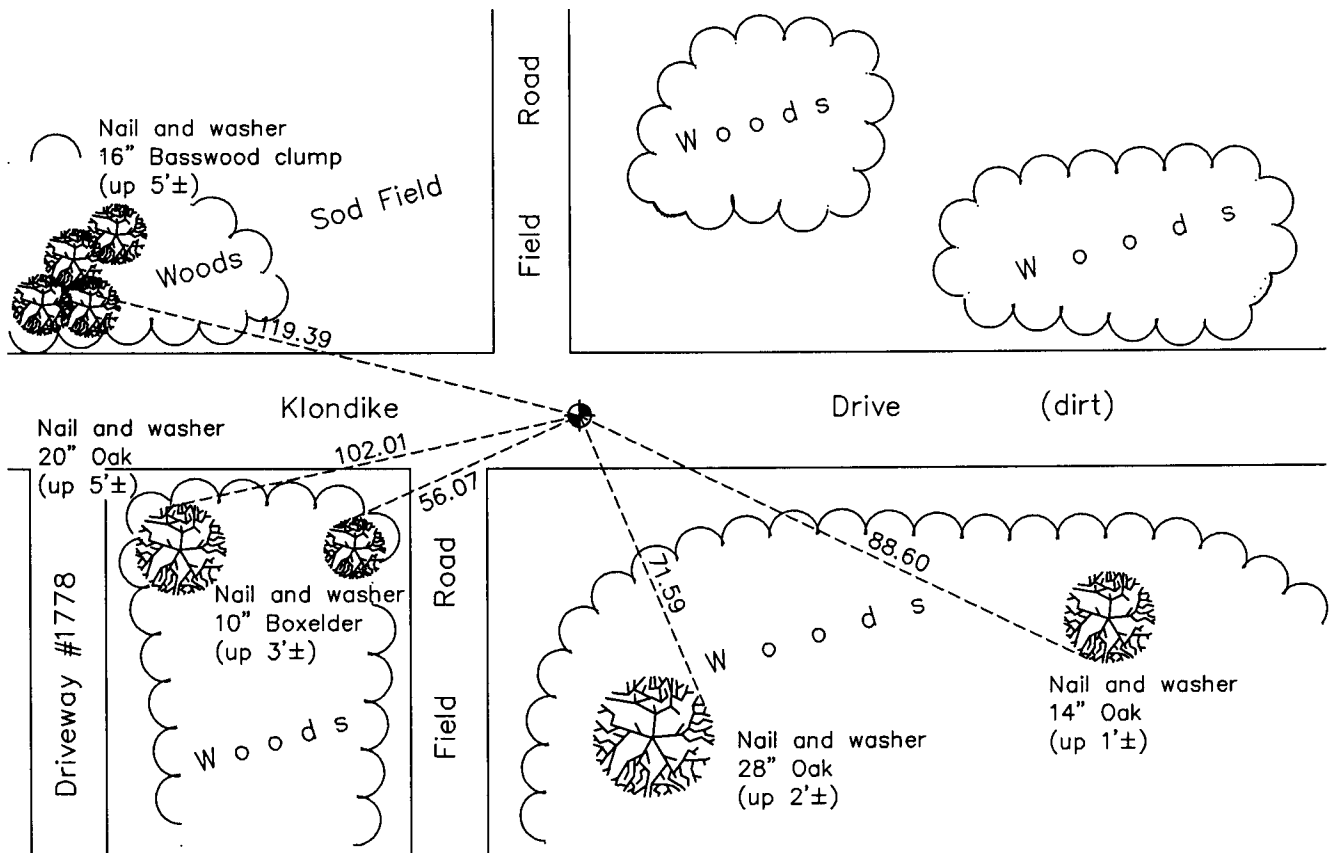

Revision Date

7/24/13

N.A.D. 1983 Coordinates
(1996 Adjustment)

County Project Coordinates	
Northing	208974.6124
Easting	510312.3527
Date	7/08/02

I hereby certify that this United States public land survey monument record is correct and complete to the best of my knowledge and belief.

Larry D. Hoium Date 7/24/13

Larry D. Hoium, Anoka County Surveyor
Minnesota License Number 18165