

CERTIFICATE OF LOCATION OF GOVERNMENT CORNER

County of Anoka

State of Minnesota



Northwest Corner of Sec. 26 Township 33 Range 23

On the ____ day of November, 1960, the described corner was evidenced by a granite monument

and to perpetuate the location of said corner, at the exact location thereof, a permanent marker was placed consisting of the same granite monument

AND on the 2nd day of August, 2012, said permanent marker was found down 0.5'± and the ties were updated

Updated reference ties are as shown below.

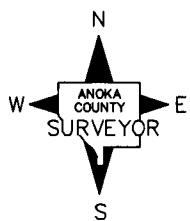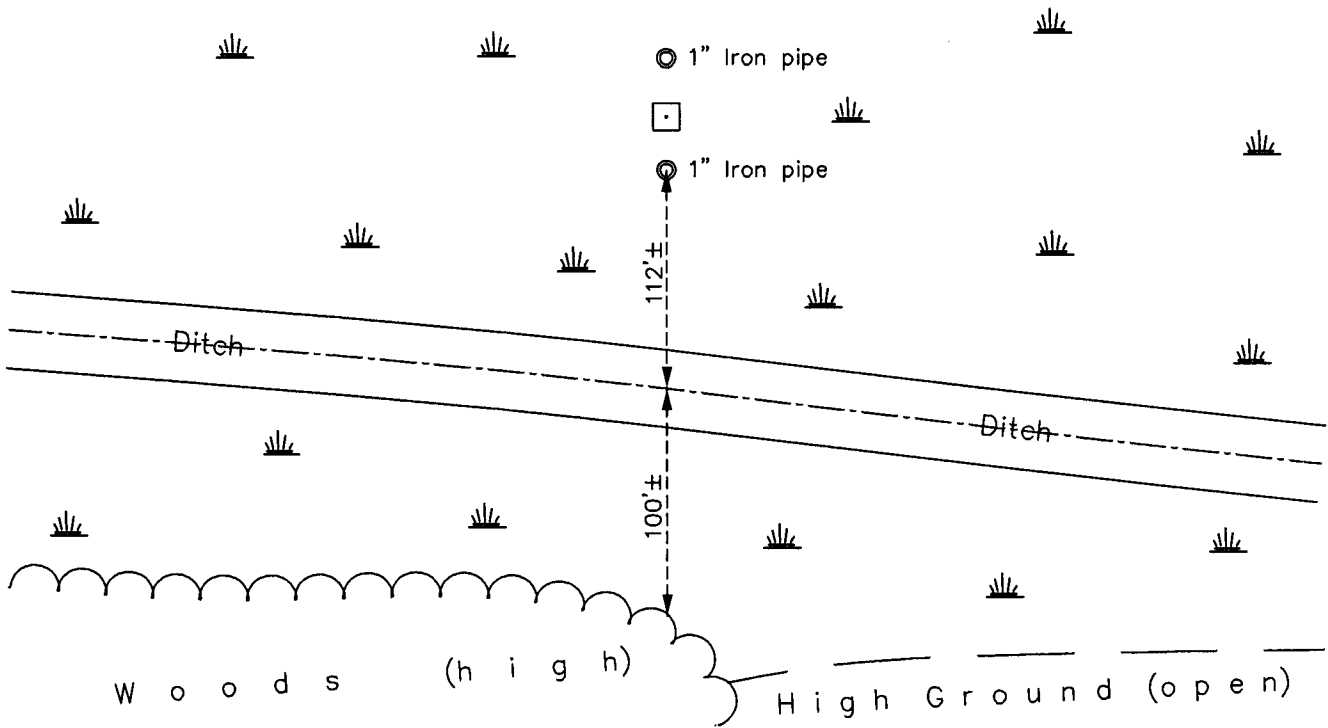

Revision Date

8/05/13

N.A.D. 1983 Coordinates
(1996 Adjustment)

County Project Coordinates	
Northing	<u>206301.5232</u>
Easting	<u>521037.0882</u>
Date	<u>3/10/03</u>

I hereby certify that this United States public land survey monument record is correct and complete to the best of my knowledge and belief.

Larry D. Hoium Date 8/05/13

Larry D. Hoium, Anoka County Surveyor

Minnesota License Number 18165