

# CERTIFICATE OF LOCATION OF GOVERNMENT CORNER

County of Anoka

State of Minnesota

## Northwest Corner of Sec. 28 Township 33 Range 23



On the 20th day of September, 1961, the described corner was evidenced by a concrete monument

and to perpetuate the location of said corner, at the exact location thereof, a permanent marker was placed consisting of a cast iron monument with a sign and post on the north side.

Monument is down 1'±.

AND on the 4th day of April, 2013, said permanent marker was found and the ties were updated. Sign was shortened and is facing north.

Updated reference ties are as shown below.

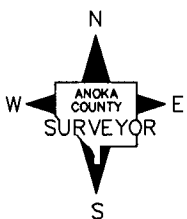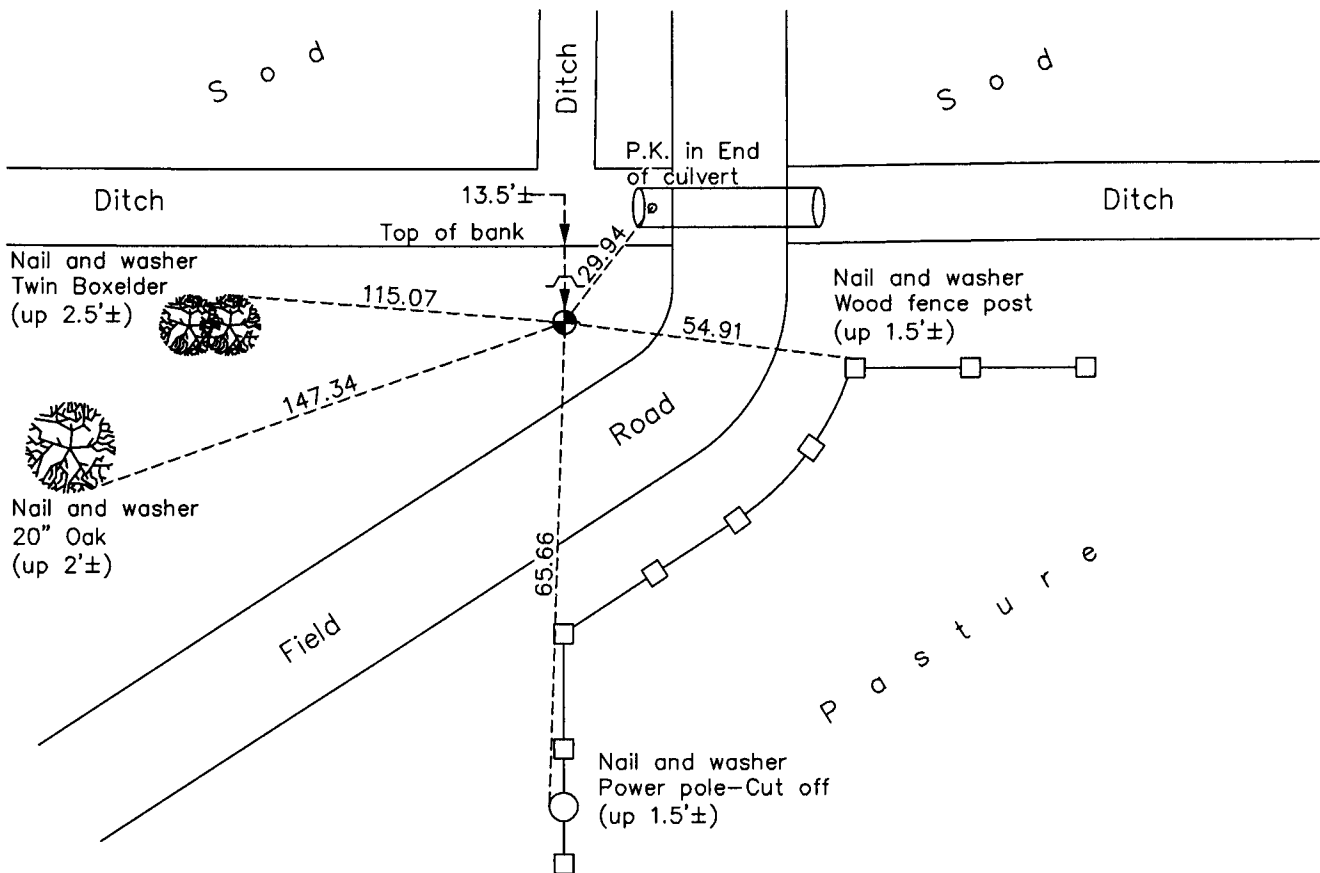

Revision Date  
8/13/13

N.A.D. 1983 Coordinates  
(1996 Adjustment)

County Project Coordinates	
Northing	206321.0286
Easting	510353.6277
Date	3/27/03

I hereby certify that this United States public land survey monument record is correct and complete to the best of my knowledge and belief.

*Larry D. Hoium* Date 8/13/13

Larry D. Hoium, Anoka County Surveyor

Minnesota License Number 18165