

# CERTIFICATE OF LOCATION OF GOVERNMENT CORNER

County of Anoka State of Minnesota


## South 1/4 Corner of Sec. 20 Township 33 Range 23

On the 5th day of June, 1944, the described corner was evidenced by a concrete monument

and to perpetuate the location of said corner, at the exact location thereof, a permanent marker was placed consisting of a cast iron monument

AND on the 13th day of September, 2006, said permanent marker was found and the ties were updated

Updated reference ties are as shown below.

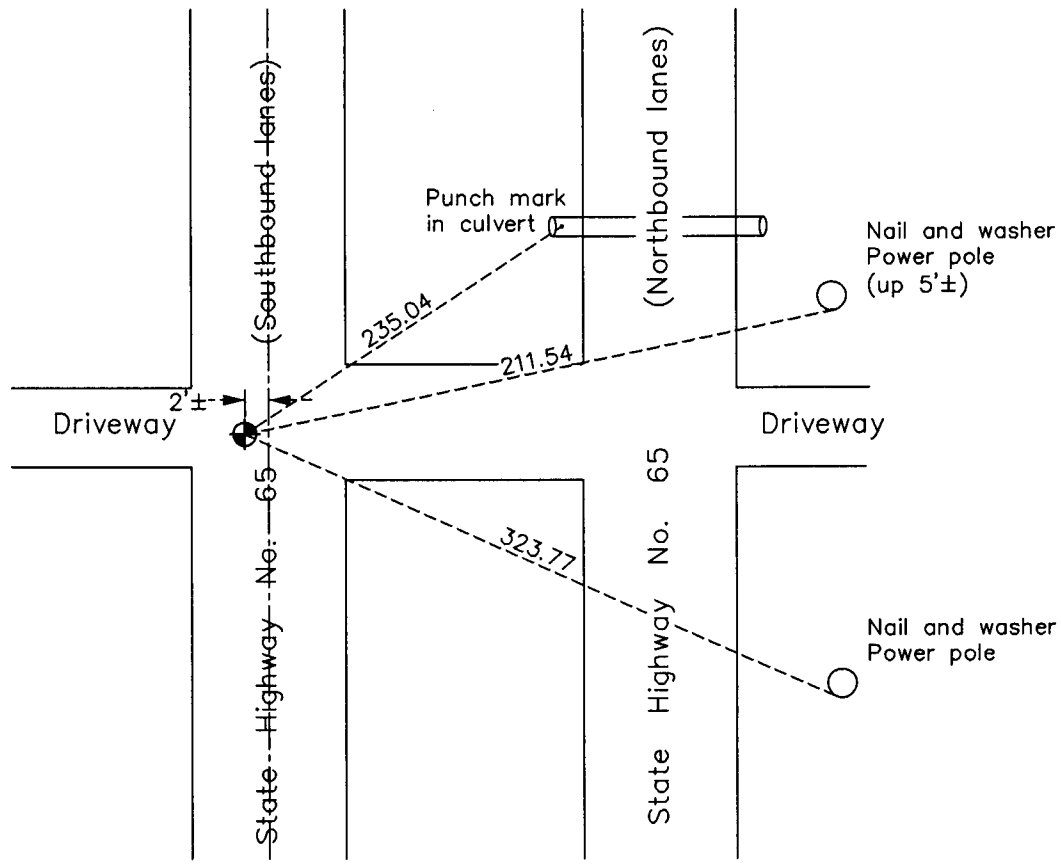

N  
ANOKA COUNTY SURVEYOR  
E  
S  
Revision Date  
8/13/13

N.A.D. 1983 Coordinates  
(1996 Adjustment)

County Project Coordinates	
Northing	206334.8143
Easting	507698.4866
Date	9/13/06

I hereby certify that this United States public land survey monument record is correct and complete to the best of my knowledge and belief.

*Larry D. Hoium* Date 8/13/13  
 Larry D. Hoium, Anoka County Surveyor  
 Minnesota License Number 18165