

CERTIFICATE OF LOCATION OF GOVERNMENT CORNER

County of Anoka

State of Minnesota



East 1/4 Corner of Sec. 27 Township 33 Range 23

On the ____ day of November, 1960, the described corner was evidenced by a cast iron monument found by N.C. Hoium and reset from area resurvey on May 21, 1969

and to perpetuate the location of said corner, at the exact location thereof, a permanent marker was placed consisting of a cast iron monument with a sign and post on the north side

AND on the 4th day of April, 2013, said permanent marker was found and the ties were updated

Updated reference ties are as shown below.

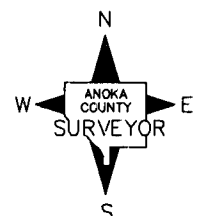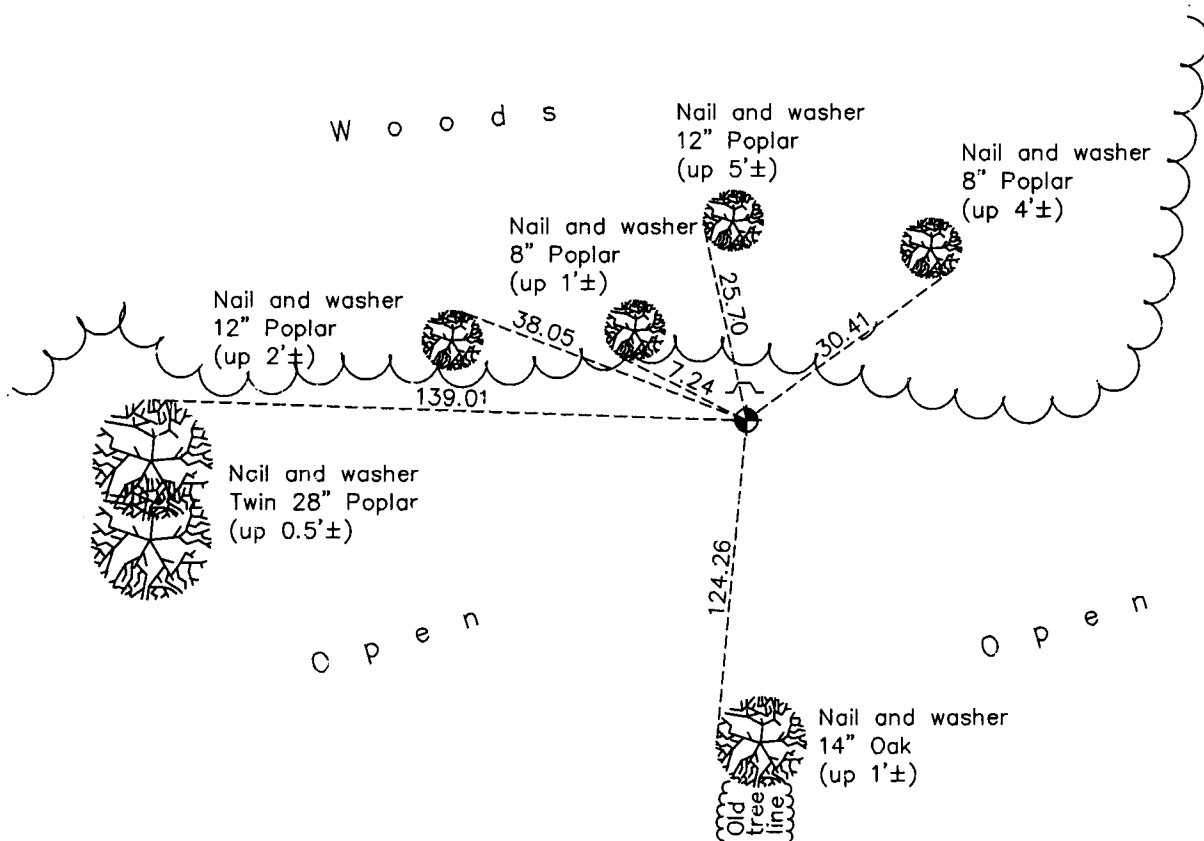

Revision Date
8/28/13

N.A.D. 1983 Coordinates
(1996 Adjustment)

County Project Coordinates	
Northing	<u>203644.0284</u>
Easting	<u>521135.1622</u>
Date	<u>7/15/02</u>

I hereby certify that this United States public land survey monument record is correct and complete to the best of my knowledge and belief.

Larry D. Hoium Date 8/28/13

Larry D. Hoium, Anoka County Surveyor

Minnesota License Number 18165