

CERTIFICATE OF LOCATION OF GOVERNMENT CORNER

County of Anoka

State of Minnesota



Witness Corner of Sec. 35 Township 33 Range 23
 (Witness corner to Meander Corner No. 9)

On the 14th day of August, 1964, the described corner was evidenced by a cast iron monument

and to perpetuate the location of said corner, at the exact location thereof, a permanent marker was placed consisting of a cast iron monument

AND on the 17th day of January, 2013, said permanent marker was found broken and leaning. Replaced broken monument with a new cast iron monument and updated ties.

Updated reference ties are as shown below.

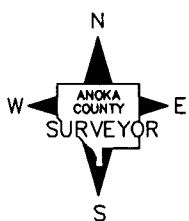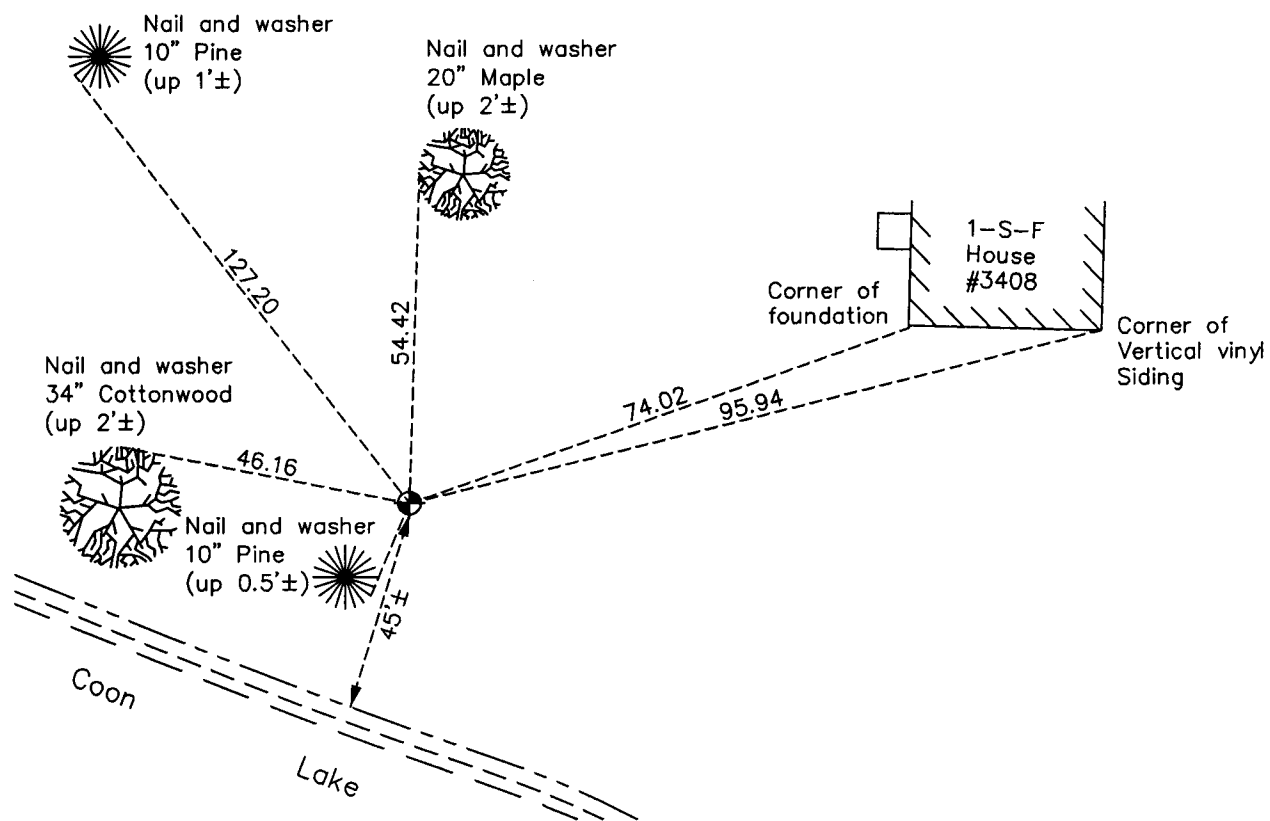

Revision Date
1/28/13

N.A.D. 1983 Coordinates
 (1996 Adjustment)

County Project Coordinates	
Northing	<u>200678.5002</u>
Easting	<u>521239.0536</u>
Date	<u>6/18/02</u>

I hereby certify that this United States public land survey monument record is correct and complete to the best of my knowledge and belief.

Larry D. Hoium Date 1/28/13

Larry D. Hoium, Anoka County Surveyor

Minnesota License Number 18165