

CERTIFICATE OF LOCATION OF GOVERNMENT CORNER

County of Anoka


State of Minnesota

CENTER Corner of Sec. 34 Township 33 Range 23

I hereby certify that on the 9 day of JUNE, 19 65, I found the described corner which was evidenced by IRON PIPE SET BY R.M. KNUDSON

and I further certify that to perpetuate the location of said corner, I did, at the exact location thereof, place a permanent marker consisting of SAME

which reference or witness monuments are located in the manner following:

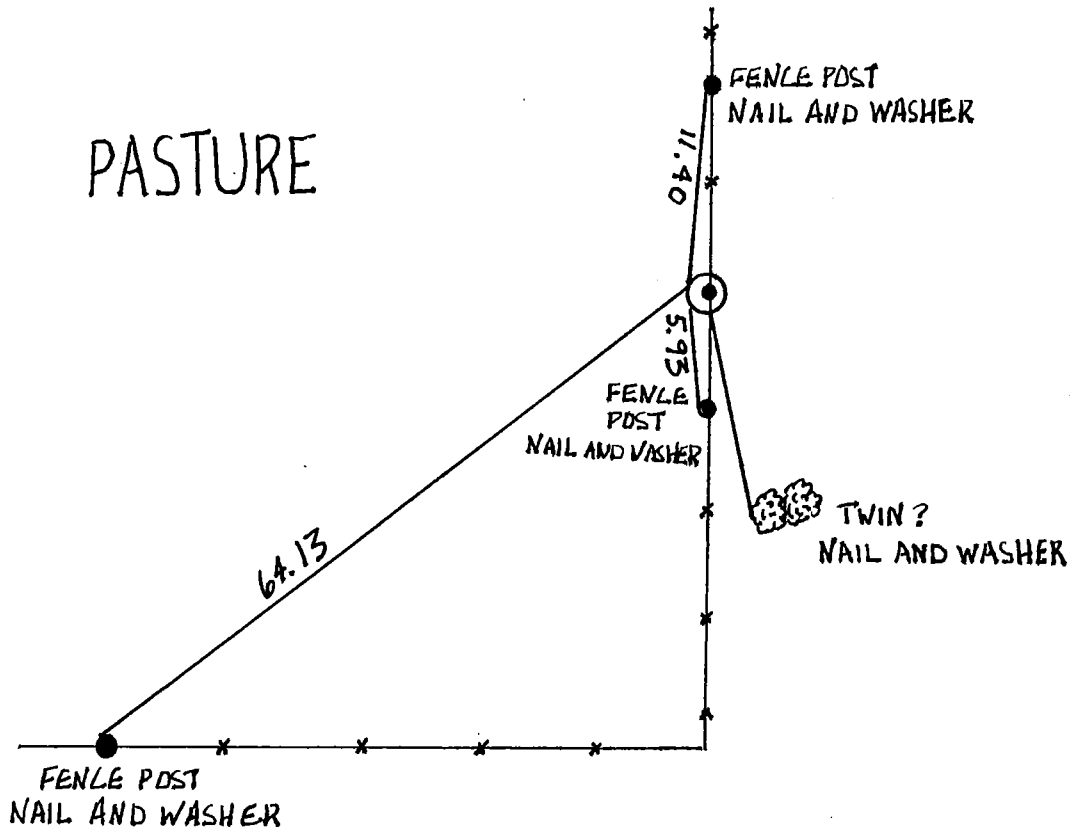

Revised date	Revised date	Revised date
6-4-87		
8-26-92		
8-15-97		

