

CERTIFICATE OF LOCATION OF GOVERNMENT CORNER

County of Anoka

State of Minnesota

Meander Corner of Sec. 35 Township 33 Range 23



(Meander Corner No. 15—on west line of section)

On the 20th day of January, 1961, the described corner was evidenced by a 1 1/2" iron pipe

and to perpetuate the location of said corner, at the exact location thereof, a permanent marker was placed consisting of a cast iron monument

AND on the 4th day of April, 2013, said permanent marker was found and the ties were updated

Updated reference ties are as shown below.

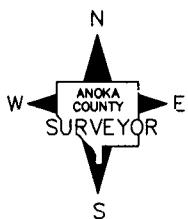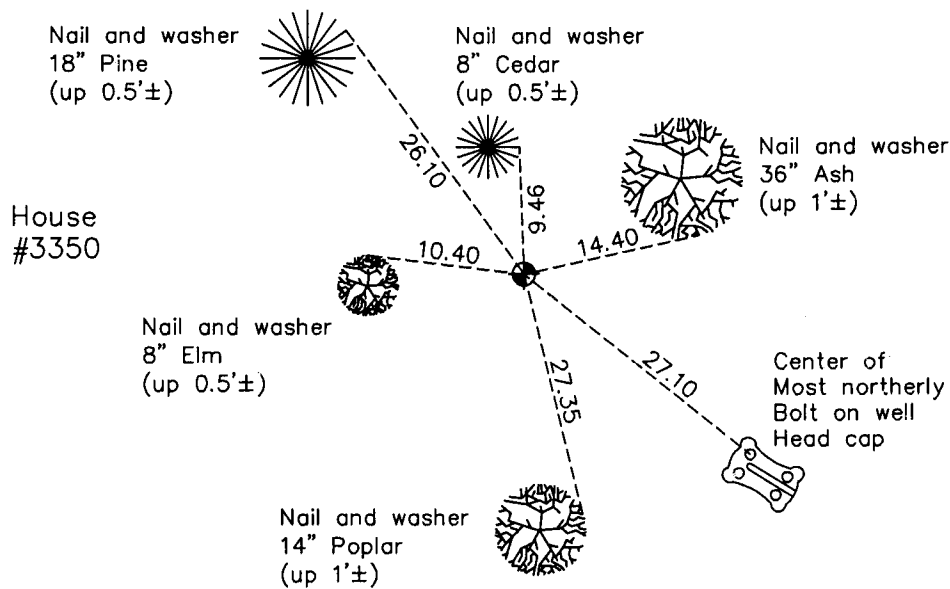

Revision Date
9/10/13

N.A.D. 1983 Coordinates
(1996 Adjustment)

County Project Coordinates	
Northing	196885.4544
Easting	521318.5335
Date	3/18/03

I hereby certify that this United States public land survey monument record is correct and complete to the best of my knowledge and belief.

Larry D. Hoium Date 9/10/13

Larry D. Hoium, Anoka County Surveyor

Minnesota License Number 18165