

CERTIFICATE OF LOCATION OF GOVERNMENT CORNER

County of Anoka

State of Minnesota


North 1/4 Corner of Sec. 25 Township 34 Range 23

On the 13th day of December, 1976, the described corner was evidenced by an Isanti County cast iron monument set by N.C. Hoium

and to perpetuate the location of said corner, at the exact location thereof, a permanent marker was placed consisting of the same cast iron monument with a sign and post on the southeast side facing north

AND on the 26th day of April, 2012, said permanent marker was found up 0.3'± and the ties were updated

Updated reference ties are as shown below.

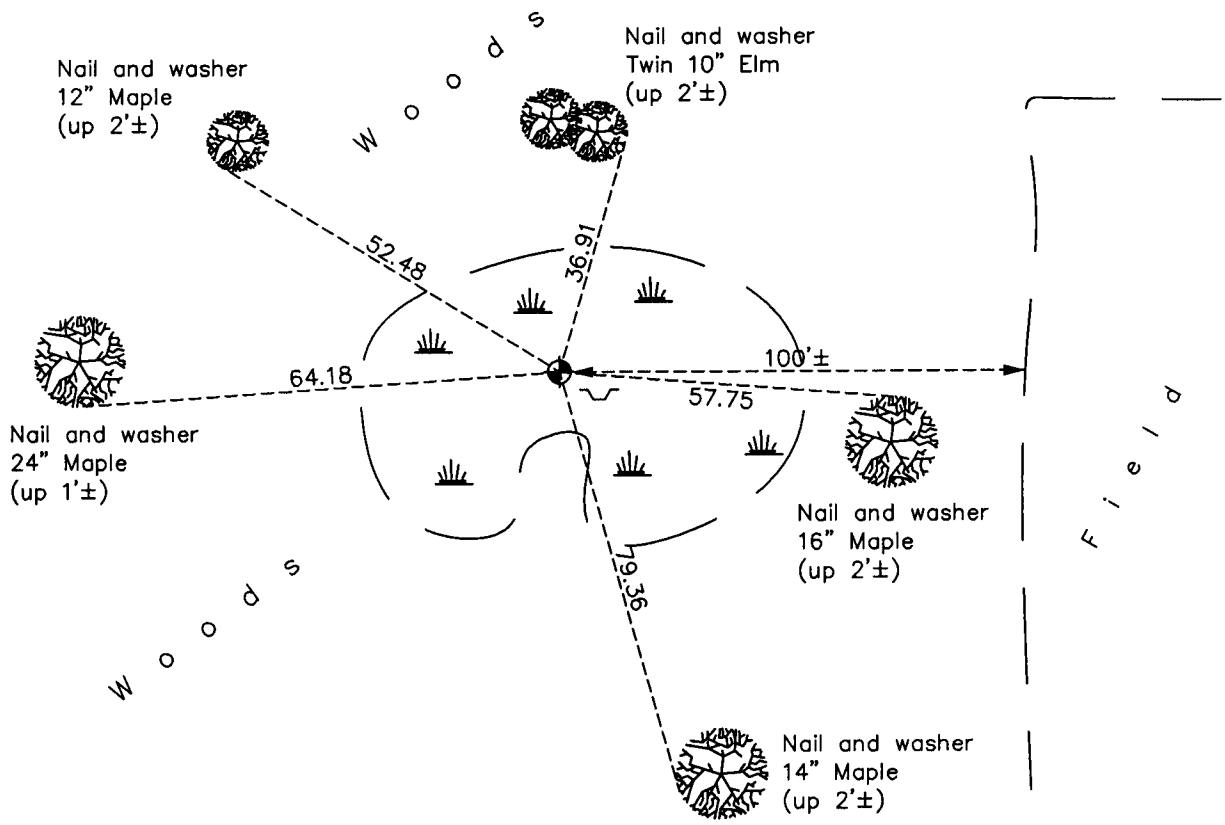

N
W ANOKA COUNTY SURVEYOR E
S

Revision Date
3/04/13

N.A.D. 1983 Coordinates
(1996 Adjustment)

County Project Coordinates	
Northing	<u>238118.8562</u>
Easting	<u>529313.8738</u>
Date	<u>4/07/03</u>

I hereby certify that this United States public land survey monument record is correct and complete to the best of my knowledge and belief.

Larry D. Hoium Date 3/04/13
 Larry D. Hoium, Anoka County Surveyor
 Minnesota License Number 18165