

# CERTIFICATE OF LOCATION OF GOVERNMENT CORNER

County of Anoka

State of Minnesota



## Southwest Corner of Sec. 27 Township 34 Range 23

On the 30th day of August, 1976, the described corner was evidenced by a 3/4" iron pipe

and to perpetuate the location of said corner, at the exact location thereof, a permanent marker was placed consisting of a red and white iron pipe

AND on the 29th day of October, 2012, said permanent marker was found up 3'± and with a sign attached facing north. Updated ties.

Updated reference ties are as shown below.

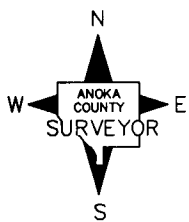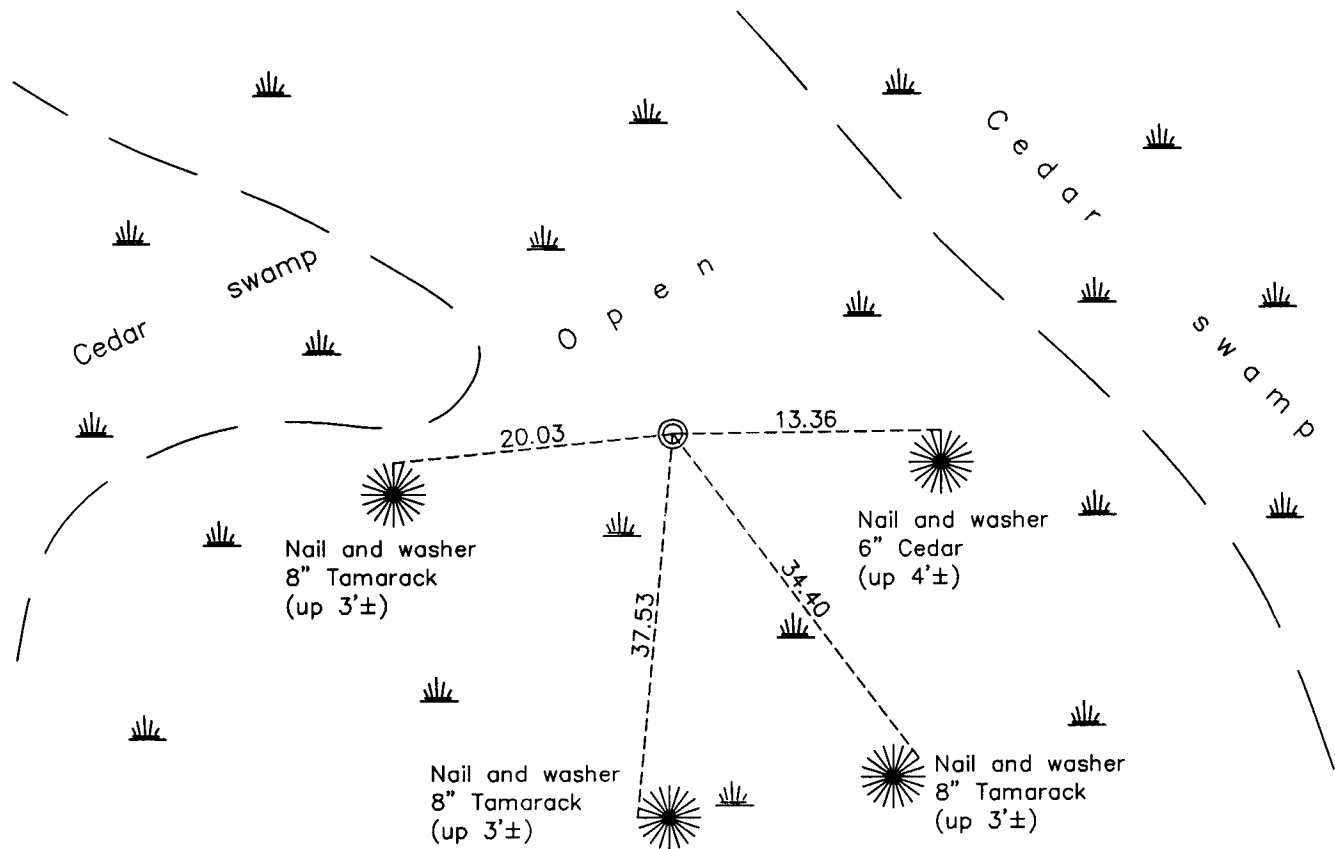

Revision Date  
3/26/13

N.A.D. 1983 Coordinates  
 (1996 Adjustment)

County Project Coordinates	
Northing	<u>232908.4122</u>
Easting	<u>516132.7463</u>
Date	<u>4/07/03</u>

I hereby certify that this United States public land survey monument record is correct and complete to the best of my knowledge and belief.

*Larry D. Hoium* Date 3/26/13  
 Larry D. Hoium, Anoka County Surveyor  
 Minnesota License Number 18165